

GEODETTIC SURVEY OF N.S.W.

CENTRAL MAPPING AUTHORITY


GEODETTIC STATION RECONNAISSANCE and MAINTENANCE REPORT

STATION: SMA 0893 No.: 506

MAP SHEET SCALE 1:250 000 CANBERRA

INSPECTED BY: G. KEEP DATE: 14.5.80

AUTHORITY: CMA FIELD BOOK:

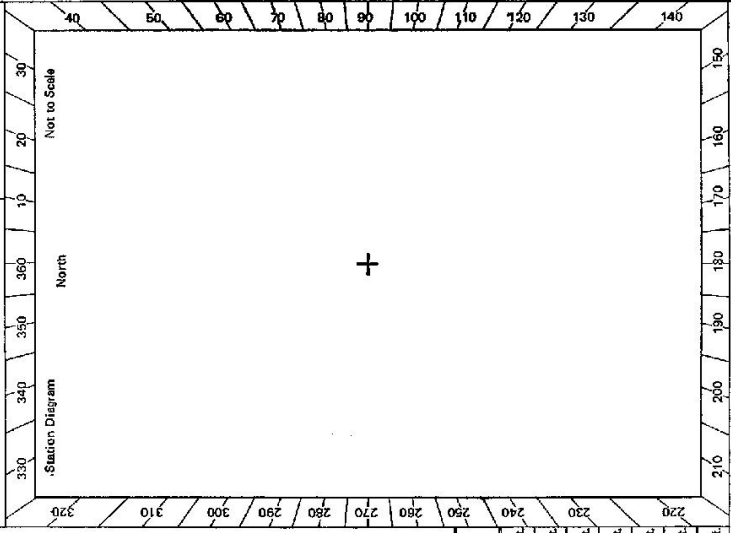


- Description:
- Note: Cross out word or words which do not apply
- Cleared by lanes bearing..... from Trig. Mast
 - ~~Mast & Vanes have been painted white & black respectively.~~
 - The station/pillar was unpiled/not unpiled/constructed on.....19..... dimensions now being:
Description of mark. **Brass Plate** should be explicit, e.g., S/Steel Pillar Plate, Steel plug, Brass plug, Bolt, G.I. Pipe
Height of mark.....m. ^{above} _{below} rock/concrete; Mark is.....m. ^{above} _{below} G.L.
Height of Top Vanes to Top Mark/Pillar platem. Diameter of Vanes (vertical).....m.
Height of Cairn.....m. Diameter of Cairn.....m. Name Plate found/not found/placed.
Length of Mastm. (approximate if not unpiled)
 - A.....set in conc/rock has been placed/found, bearing.....° M from Mast/Plug/Pillar
 - A.....set in conc/rock has been placed/found, bearing.....° M from Mast/Plug/Pillar
 - A.....set in conc/rock has been placed/found, bearing.....° M from Mast/Plug/Pillar
 - A.....set in conc/rock has been placed/found, bearing.....° M from Mast/Plug/Pillar
 - Action required: **Needs to be painted white and black. No clearing necessary.**

STANDPOINT:			
Mark	Direction	Horiz. Distance	Height Difference
			above standpt
			below standpt
			above standpt
			below standpt
Prepared by: G. Keep 4/5/80
Checked: [Signature] 11/5/81
Noted on U.T.M. Card

68
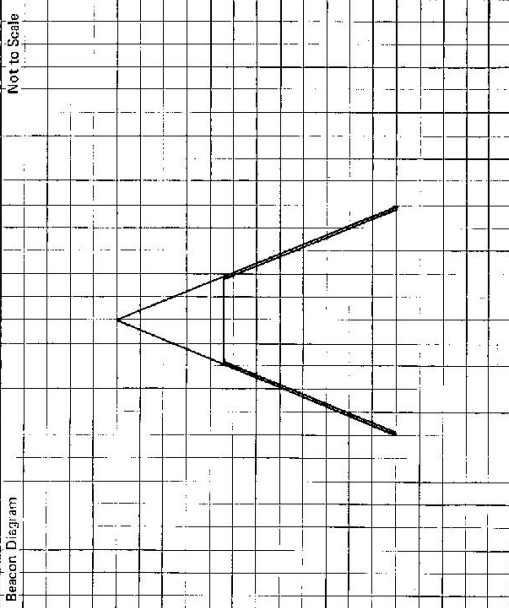
<p>STATION SMA 0893 TS 506</p> <p>Owner's Name: Address: Phone:</p> <p>Current Occupant: Address: Phone:</p> <p style="text-align: center;"><u>ACCESS</u></p> <p>Access Report of 14.5.1980 was found suitable/unsuitable. Access from Yaouk Road Refer to Shannons Flat 8626-II-S (1:25 000)</p>	<p>Not to Scale</p>  <p>This section to be completed by officer constructing pillar.</p> <p>Original station mark found/not found.</p> <p>Description of mark:</p> <p>Original beacon found/not found.</p> <p>Description of beacon:</p> <p>Height Top of Varies to Top Mark.....m.</p> <p>Height of mark.....m. above G.L. below</p> <p>Diameter of Varies.....m. Height of Cairn.....m.</p> <p>Original Beacon has/has not been destroyed by me.</p>
<p>Date</p>	
<p>Record of Station</p>	