

CENTRAL MAPPING AUTHORITY  
Department of Lands

Trigonometrical Survey of N.S.W.

RECONNAISSANCE and MAINTENANCE REPORT

STATION **IBBINSBAR TS. 5062**

Co: STATE OF QLD | P1: STATE OF QLD

Map Sheet: **STANTHORPE** | No: **9240**

Inspected by: **D. HALLS** | Date: **4th August 76**

Authority: **CMA 72/66** | Field Book: **01389/19,20**

Beacon Diagram: **Not to Scale**

Note: Cross out word or words which do not apply

This Trig. Station has been:-

1. Completely cleared to permit 360° vision to surrounding Trigs.
2. Cleared by lanes bearing..... from Trig. Mast
3. Trig. Mast & Vanes have been painted white & black respectively.
4. The Trig. was unpiled/~~not unpiled~~, dimensions now being: **Original Station Mast found / not found**

Description of mark: **STEEL P.O. IN CONC.** should be explicit, e.g. Steel plug, Brass plug, Bolt, C.I. Pipe  
 Height of mark..... m above rock/concrete ..... m below G.L.  
 Height of Top Vanes to Top Mark..... m. Diameter of Vanes (vertical) **1080**..... m.


Height of Cairn..... m. Diameter of Cairn **200**..... m.  
 Length of Mast **2200**..... m. (approximate if not unpiled)

5. A <sup>Round</sup> ~~headed~~ <sub>bolt</sub> set in conc/rock has been placed **4.476** m. bearing **205** °M from Trig. Mast
6. A..... set in conc/soil has been placed..... m. bearing..... °M from Trig. Mast
7. A..... set in conc/soil has been placed..... m. bearing..... °M from Trig. Mast
8. A..... set in conc/rock has been placed..... m. bearing..... °M from Trig. Mast

9. Connection: **Bolt to Trig plug: 4.476** m. bearing **115** °M

10. Connection..... to..... m. bearing..... °M
11. Connection..... to..... m. bearing..... °M
12. Connection..... to..... m. bearing..... °M
13. Diff. Ht. **Round Headed Bolt** is **0.488** m. <sup>above</sup> <sub>below</sub> Trig. Mark
14. Diff. Ht. .... is..... m. <sup>above</sup> <sub>below</sub>
15. Diff. Ht. .... is..... m. <sup>above</sup> <sub>below</sub>
16. Diff. Ht. .... is..... m. <sup>above</sup> <sub>below</sub>

Prepared by: ..... Checked: **Noted on U.T.M. Card**

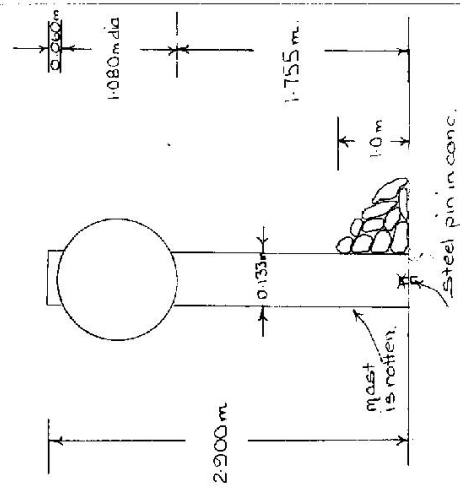

Date	Record of Station

Checked

STATION JIBINBAR T.S. 5062.

Current Occupant .....

Address .....

Owners Name .....


Address .....

Access .....

Not to Scale

Station Diagram

Grid North

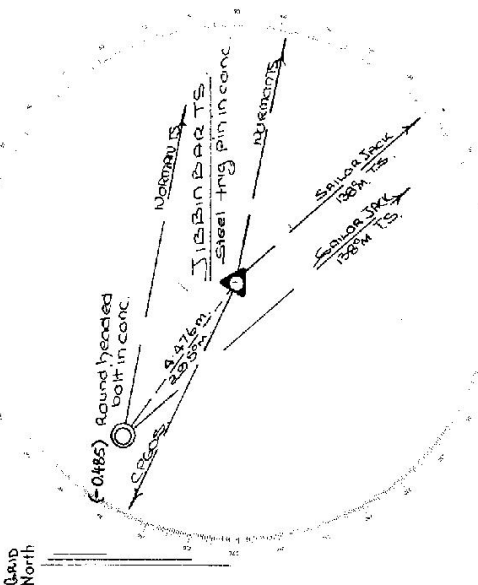

List of Observed Directions:-

Standpoint: TRIG PLUG		Standpoint: Round headed BOLT in CONC.	
Station	Direction	Station	Direction
NORMAN T.S.	15°23'02.5"	NORMAN T.S.	205°23'40.5"
SAILOR JACK T.S.	0°00'00"	TRIG PIN	133°00'00"
CONC.	148°34'51.5"	SAILOR JACK T.S.	138°00'00"
BOLT IN CONC.	135°00'00"		

Station	Direction	Station	Direction