


CENTRAL MAPPING AUTHORITY
Department of Lands

Trigonometrical Survey of N.S.W.
RECONNAISSANCE and MAINTENANCE REPORT

STATION **MAGNUS T.S. Queensland**
5066

Co: _____ Ph: _____
Map Sheet: **SPAINTHORPE** No: **4240**
Inspected by: **D KAIN** Date: **4 JUNE 1973**
Authority: **C.M.A.** Field Book: _____

Beacon Diagram Not to Scale

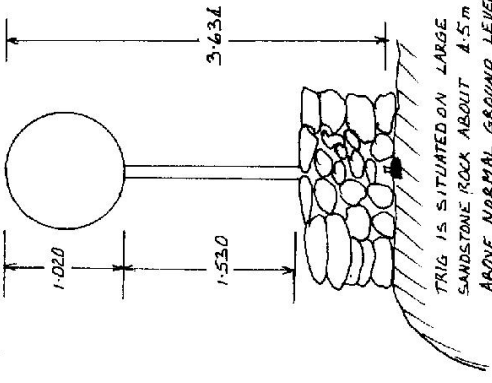

Date _____ Record of Station _____
Checked _____

Note: Cross out word or words which do not apply

1. Completely cleared to permit 360° vision to surrounding Trigs.
2. Cleared by lances bearing **55° 32' M** from Trig. Mast
3. Trig. Mast & Vanes have been painted white & black respectively.
4. The Trig. was unpiled/~~not unpiled~~, dimensions now being:
 - Description of mark: **COPPER PILES** should be explicit, e.g. Steel plug, Brass plug, Belt, G.I. Pipe
 - Height of mark: **2.014** m ^{above} ~~below~~ rock/concrete m ^{above} ~~below~~ G.L.
 - Height of Top Vanes to Top Mark: **3.634** m. Diameter of Vanes (vertical): **1.020** m.
 - Height of Cairn: **1.10** m. Diameter of Cairn: **2.3** m.
 - Length of Mast: **3.634** m. (approximate if not unpiled)
5. **A DRILL HOLE 1** set in ~~conc/rock~~ has been ~~placed~~ ^{fd} **2.209** m. bearing **58**°M from Trig. Mast
6. **A DRILL HOLE 2** set in ~~conc/rock~~ has been ~~placed~~ ^{fd} **6.045** m. bearing **335**°M from Trig. Mast
7. **A DRILL HOLE 3** set in ~~conc/rock~~ has been placed **7.575** m. bearing **252**°M from Trig. Mast
8. **A** set in conc/rock has been placed m. bearing°M from Trig. Mast
9. Connection **DRILL HOLE 1** to **DRILL HOLE 2**: **6.475** m. bearing **308**°M
10. Connection **DRILL HOLE 3** to **DRILL HOLE 2**: **8.862** m. bearing **31**°M
11. Connection to m. bearing°M
12. Connection to m. bearing°M
13. Diff. Ht. is m. ^{above} ~~below~~
14. Diff. Ht. is m. ^{above} ~~below~~
15. Diff. Ht. is m. ^{above} ~~below~~
16. Diff. Ht. is m. ^{above} ~~below~~


Prepared by: _____ Checked: _____
Noted on U.T.M. Card **UN74**

LAND INFORMATION CENTRE

GEODETIC SURVEY OF N.S.W.

GEODETIC STATION RECONNAISSANCE and MAINTENANCE REPORT

STATION: **MAGNUS CS. (GALD)** TS No.: **5066**
 MAP SHEET SCALE 1:250 000 **WARWICK**
 INSPECTED BY: **G Ford** DATE: **1-8-92**
 AUTHORITY: **L.I.C.** FIELD BOOK: **2103**

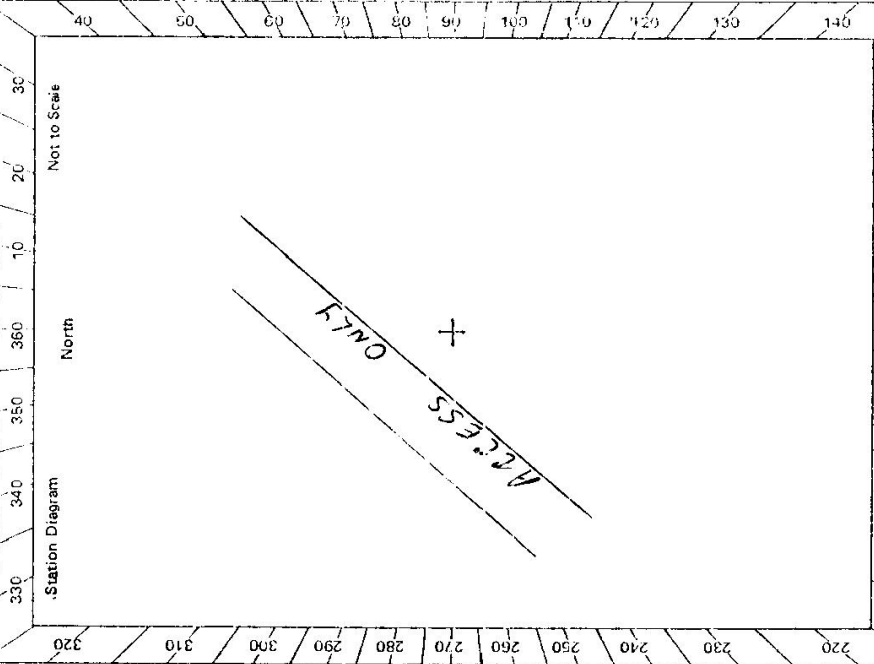

Description:
 1. Cleared by lanes bearing **CLEARED FOR G.P.S. DOWN TO ABOUT 15° ELEVATION** from Trig. Mast
 2. Mast & Vanes have been painted white & black respectively.
 3. The station/pillar was unpiled/not unpiled/constructed on 19....., dimensions now being:
 Description of mark **COPPER PLUG** should be explicit, e.g., S/Steel Pillar Plate, Steel plug, Brass plug, Bolt, G.I. Pipe
 Height of mark **0.016** m. ^{above} rock/concrete; Mark is m. ^{above} G.L.
 Height of Top Vanes to Top Mark/Pillar plate m. Diameter of Vanes (vertical) m.
 Height of Cairn m. Diameter of Cairn m. Name Plate found/not found/placed.
 Length of Mast m. (approximate if not unpiled)
 4. A. **BRASS MARK** set in **conc/rock** has been placed/found, bearing ° M from Mast/Plug/Pillar
 5. A. **BRASS MARK** set in **conc/rock** has been placed/found, bearing ° M from Mast/Plug/Pillar
 6. A. set in **conc/rock** has been placed/found, bearing ° M from Mast/Plug/Pillar
 7. A. set in **conc/rock** has been placed/found, bearing ° M from Mast/Plug/Pillar
 8. Action required: **MAST & VANES DOWN, THROW OFF LARGE ROCK WITH ROCKS FROM CRIM.**
(NEEDS NEW MAST & VANES)

STANDPOINT:				STANDPOINT:			
Mark	Direction	Horiz. Distance	Height Difference	Mark	Direction	Horiz. Distance	Height Difference
			above standpt.				above standpt.
			below				below
			above standpt.				above standpt.
			below				below
Prepared by: **J. Ford 27/9/92** Checked: **Noted on U.T.M. Card**
 S: 2735-1

TS 5066

Beacon Diagram: 	<p style="text-align: center;">STATION MAGNUS CS (GLD)</p> <p>Owner's Name: MR WALLY MOSS Address: POZIERS VIA THULIMBAH VILLAGE (076) 853 259 (NIGHT TIME BEST)</p> <p>Current Occupant: Address: Phone: 1-8-1992</p> <p>Access Report of 4.6.73 was found unsuitable/unsuitable.</p> <p>STANTHORPE P.O. TRAVEL 12. ASHM NORTH ALONG H.W.J TOWARDS WARWICK TO THE VILLAGE OF THULIMBAH</p> <p>0.00 TURN LEFT INTO AMIERS RD SIGN POST AT MAGNUS WINERY [OPP RAILWAY STATION.]</p> <p>1.49 STRAIGHT AHEAD AT CROSS ROADS</p> <p>7.57 TURN RIGHT INTO POZIERS RD [OPP ROAD TO MT. MAGNUS CELLARS]</p> <p>8.29 TURN LEFT INTO POZIERS SCHOOL ROAD</p> <p>8.68 PASS POZIERS STATE SCHOOL ON LEFT</p> <p>10.16 TURN LEFT AT T INTERSECTION [AT END OF TRAIL RD]</p> <p>11.92 PASS SCOTTS CAMP RD ON LEFT</p> <p>14.14 GRID ON DINGO FENCE TAKE LEFT FORK</p> <p>14.24 HOUSE ON R.H.S. OWNERS HOUSE</p> <p>14.29 GRID</p> <p>14.50 GRID</p> <p>14.63 TURN RIGHT OFF MAIN TRACK FOLLOW FAINT TRACK THROUGH MAINLY DEAD TAMBER [MORE OR LESS FOLLOWING FENCE LINE]</p> <p>16.42 END OF FAINT TRACK MAKE OWN WAY TO BASE OF HILL</p> <p>16.73 BASE OF HILL REMAINS WALK UP ROCKY HILL WITH LIGHT LOAD WALK UP N.E. SIDE OF HILL TRIG IS ON N.W. END OF HILL ON LARGE ROCK</p>
	This section to be completed by officer constructing pillar. Original station mark found/not found.
	Description of mark: Original beacon found/not found.
	Description of beacon: Height Top of Vanes to Top mark.....m. Height of mark.....m. above G.L. below G.L. Diameter of Vanesm. Height of Cairnm. Original Beacon has/has not been destroyed by me.
	Date Record of Station