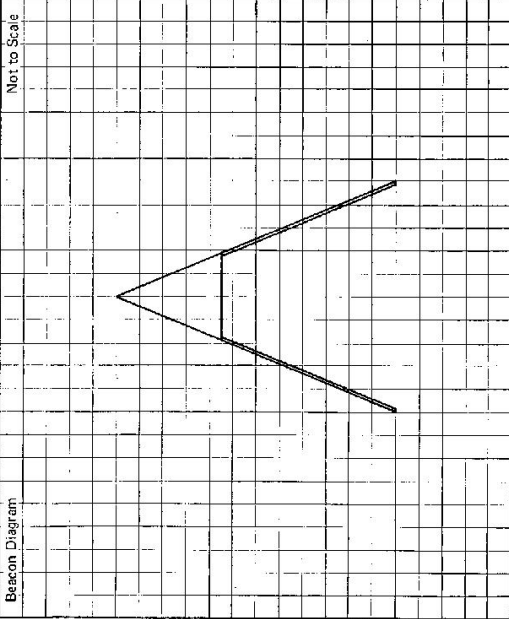


GS

<p>STATION SMA 0895 IS 508</p>	<p>Owner's Name: Address: Phone:</p> <p>Current Occupant: Address: Phone:</p> <p style="text-align: center;">ACCESS</p> <p>Access Report of <u>14.5.1988</u> was found suitable/unsuitable. Access from Adaminaby - Canberra Road Refer to Shannons Flat 8626-11-5 (1:25 000)</p>
<p>Beacon Diagram</p>	<p>Not to Scale</p> 
<p>This section to be completed by officer constructing pillar.</p> <p>Original station mark found/not found.</p> <p>Description of mark:</p> <p>Original beacon found/not found.</p> <p>Description of beacon:</p> <p>Height Top of Vanes to Top Markm.</p> <p>Height of mark:m. above rock/concm. below G.L.</p> <p>Diameter of Vanesm. Height of Cairnm.</p> <p>Original Beacon has/has not been destroyed by me.</p>	
<p>Date</p>	<p>Record of Station</p>