


Department of Lands
 STATION **TS 5083 MOLE (PM 3421)**
 Co: **CUMBERLAND** Ph: **MANLY COVE**
 Map Sheet: **MT. COLAHY 1:18000** No: **0987**
 Inspected by: **H. C. BARNER** Date: **8 16 1883**
 Authority: **LANDS DEPT** Field Book: **5031/13**

Beacon Diagram
 Not to Scale

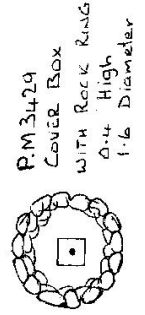

Integral Survey of N.S.W.
 RECONNAISSANCE and MAINTENANCE REPORT

This Trig. Station has been: Note: Cross out word or words which do not apply

1. Completely cleared to permit 360° vision to surrounding Trigs.
2. Cleared by lines bearing **347°M** **356°M** from Trig. Mast
3. Trig. Mast & Vanees have been painted white & black respectively.

4. The Trig. was unpiled/net unpiled, dimensions now being:
 Description of mark: **BLOUNT'S PLUG COVER BOX 0.022 PLUG PM 3421**
 Height of mark: **0.25** m above rock/concrete m above G.L.
 Height of Top Vanees to Top Mark/Top pillar plate: m Diameter of Vanees (vertical) m.
 Height of Cairn: **0.4** m. Diameter of Cairn: **1.6** m.
 Length of Mast: m. (approximate if not unpiled)

5. A **PM 53334** set in conc/soil has been placed/fd **70.350** m. bearing **347°** from Trig. Mast/pillar
6. A **(Cairn 5083)** set in conc/soil has been placed/fd **66.345** m. bearing **356°** from Trig. Mast/pillar
7. A set in conc/soil has been placed/fd m. bearing from Trig. Mast/pillar
8. A set in conc/rock has been placed/fd m. bearing from Trig. Mast/pillar

9. Connection: **PM 53334** to **Cairn 5083** **12.112** m. bearing **100°** from Trig. Mast/pillar
10. Connection: to m. bearing from Trig. Mast/pillar
11. Connection: to m. bearing from Trig. Mast/pillar
12. Connection: to m. bearing from Trig. Mast/pillar
13. Diff. Ht. **PM 53334** is **2.122** m. above **PLUG**
14. Diff. Ht. **PM 53334** is **2.174** m. above **PLUG**
15. Diff. Ht. is m. above
16. Diff. Ht. is m. above

Prepared by: **R. LAWLER** Checked: **SB**

Date	Record of Station
17/1/83	SCARBY + LOCAL CONVECTIONS

