

CENTRAL MAPPING AUTHORITY

GEODETIC SURVEY OF M.S.W. GEODETIC STATION RECONNAISSANCE and MAINTENANCE REPORT

- Description:
- Cleared by lanes bearing $166^\circ - 62^\circ M$. Note: Cross out word or words which do not apply from Trig. Mast
 - Mast & Vanes have been painted white & black respectively. Circle in black. ~~Circle in black~~
 - The station/pillar was unpiled/not unpiled/constructed on 19....., dimensions now being: Description of mark. ~~Circle in black~~ should be explicit, e.g. Steel Pillar Plate, Steel plug, Brass plug, Bolt, G.I. Pipe
 - Height of mark.....m. above rock/concrete; Mark is.....m. above G.L.
 - Height of Top Vanes to Top Mark/Pillar plate.....m. Diameter of Vanes (vertical).....m.
 - Height of Cairn.....m. Diameter of Cairn.....m. Name Plate found/not found/pileted.
 - Length of Mast.....m. (approximate if not unpiled)
 - A.....set in conc/rock has been placed/found, bearing.....° M from Mast/Plug/Pillar
 - A.....set in conc/rock has been placed/found, bearing.....° M from Mast/Plug/Pillar
 - A.....set in conc/rock has been placed/found, bearing.....° M from Mast/Plug/Pillar
 - A.....set in conc/rock has been placed/found, bearing.....° M from Mast/Plug/Pillar

Action required:..... **BARRIER**,
Set. Topo

STANDPOINT:


Mark	Direction	Horiz. Distance	Height Difference	Mark	Direction	Horiz. Distance	Height Difference
			above standpt.				above standpt.
			below				below
			above standpt.				above standpt.
			below				below
Prepared by: *[Signature]* 23.1 Checked: *[Signature]*
Noted on U.T.M. Card

STATION: MOULLATTOO No.: 5085
 MAP SHEET SCALE 1:250 000 Wollonsong
 INSPECTED BY: A. Sivertsen DATE: 9-1-79
 AUTHORITY: CMA FIELD BOOK: 1723

Station Diagram
 Only cleared area is usable as it is below top of hill on cliff edge.
 Pillar Δ site

Sr 2799-2 D. West, Government Printer
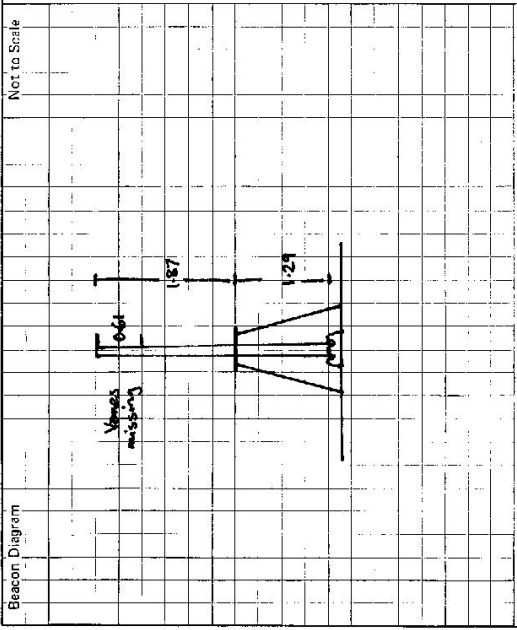
<p>STATION MOOLLATTOO IS 5085</p> <p>Owner's Name: In MORTON NATIONAL PARK</p> <p>Address:</p> <p>Phone:</p> <p>Current Occupant:</p> <p>Address:</p> <p>Phone:</p> <p>ACCESS</p> <p>Access Report of 11/1/1979 was found suitable/unsuitable.</p> <p>Km</p> <p>0.0 KANGAROO VALLEY P.O. take road towards MOSS VALE</p> <p>0.7 Turn L towards BUDGONG, MT. SCANZI</p> <p>5.5 PASS MT SCANZI road on L</p> <p>17.0 Met stn on L</p> <p>20.3 Turn L up small cutting onto gravel road.</p> <p>21.8 End of track. Walk straight ahead then follow track to L. 5 min easy walk</p>	<p>Net to Scale</p>  <p>This section to be completed by officer constructing pillar.</p> <p>Original station mark found/not found.</p> <p>Description of mark:</p> <p>Original beacon found/not found.</p> <p>Description of beacon:</p> <p>Height Top of Vanes to Top Markm.</p> <p>above below</p> <p>Height of markm. rock/concm. above G.L. below</p> <p>Diameter of Vanesm. Height of Cairnm.</p> <p>Original Beacon has/has not been destroyed by me.</p>
<p>Date</p> <p>Period of Station</p>	

CENTRAL MAPPING AUTHORITY

GEODETIC SURVEY OF N.S.M.

GEODETIC STATION RECONNAISSANCE and MAINTENANCE REPORT

Description:

1. Cleared by lanes bearing 180° M ~ 75° M

2. Mast & Vanes have been painted white & black respectively, ---

3. The station pillar was ~~unplaced~~ ~~replaced~~ /constructed on M.A.Z. $19.6.2.$, dimensions now being:
 Description of mark 50.0 M ^{above} ~~below~~ G.L.
 Height of mark 50.0 M ^{above} ~~below~~ rock/concrete; Mark is 50.0 M ^{above} ~~below~~ G.L.
 Height of Top Vanes to Top Mark/Pillar plate 50.0 M ^{above} ~~below~~ G.L.
 Diameter of Vanes (vertical) 50.0 M
 Height of Cairn 50.0 M
 Diameter of Cairn 50.0 M
 Name Plate found/not found/placed.
 Length of Mast 50.0 M (approximate if not unplaced)


4. A. 50.0 M set in conc/rock has been placed/found, bearing 180^{\circ} M from Mast/Plug/Pillar

5. A. 50.0 M set in conc/rock has been placed/found, bearing 180^{\circ} M from Mast/Plug/Pillar

6. A. 50.0 M set in conc/rock has been placed/found, bearing 180^{\circ} M from Mast/Plug/Pillar

7. A. 50.0 M set in conc/rock has been placed/found, bearing 180^{\circ} M from Mast/Plug/Pillar

8. Action required: LIMITED USE AS THIS IS IN BOTTOM OF VALLEY

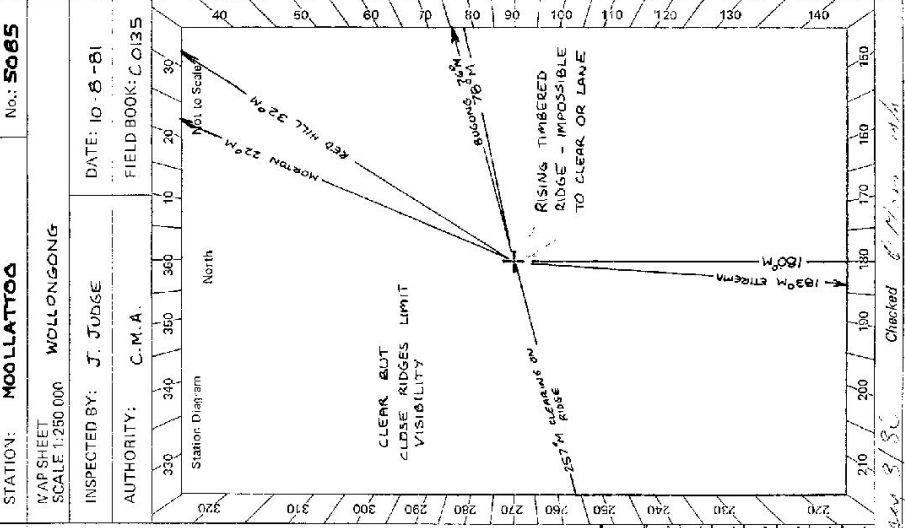

STANDPOINT:

Mark	Direction	Horiz. Distance	Height Difference	Mark	Direction	Horiz. Distance	Height Difference
			above standpt.				above standpt.
			below standpt.				below standpt.
			above standpt.				above standpt.
			below standpt.				below standpt.
Prepared by: M.L.L. 23/5/21

Checked: M.L.L.

Noted on U.T.M. Card

GS 24

STATION	MOOLLATTOO TS 5085
<p>Owner's Name: <u>MOORON NATIONAL PARK</u></p> <p>Address:</p> <p>Phone:</p> <p>Access Report of <u>10/8/1981</u> was found suitable/unsuitable.</p> <p>Feature</p> <p><u>0-0</u> P.O. KANGAROO VALLEY ~ DRIVE TOWARDS MOSS VALE.</p> <p><u>0-6</u> TURN LEFT ~ SIGN 'TALLOWA DAM'</p> <p><u>5-4</u> PASS ROAD ON LEFT TO MI SCANZI & BUDGONG</p> <p><u>16-81</u> METEOROLOGICAL STATION ON LEFT.</p> <p><u>20-17</u> TURN LEFT ALONG DIRT TRACK ~ OPPOSITE GRAVEL STOCKPILE</p> <p><u>21-70</u> PARK TRUCK AT VEHICLE TURNAROUND AT END OF TRACK FOLLOW FOOTTRACK ON 310°M FOR 40 METRES THEN FOLLOW TRACK VEERING TO THE LEFT AT 265°M. ABOUT 3 MINUTES WALK.</p>	<p>Current Occupant:</p> <p>Address:</p> <p>Phone:</p> <p style="text-align: center;">ACCESS</p>
<p>Beacon Diagram</p> <p style="text-align: right;">Not to Scale</p>	<p>Date</p> <p style="text-align: center;">Record of Station</p>
<p>This section to be completed by officer constructing pillar.</p> <p>Original station mark found/not found.</p> <p>Description of mark:</p> <p>Original beacon found/not found.</p> <p>Description of beacon:</p> <p>Height Top of Vanes to Top Markm.</p> <p>Height of markm. ^{above} rock/contcm. ^{below} G.L.</p> <p>Diameter of Vanesm. Height of Cairnm.</p> <p>Original Beacon has/has not been destroyed by me.</p>	