

7-193

Department of Lands

Integra Survey of N.S.W.

RECONNAISSANCE and MAINTENANCE REPORT 5099

STATION

T.S. WILBERFORCE

RES (e) 5099

This Trig. Station has been:-

Note: Cross out word or words which do not apply

1. Completely cleared to permit 360° vision to surrounding Trigs.
2. Cleared by lanes bearing..... from Trig. Mast

Co: _____ Phi: _____

Map Sheet: _____ No: _____

Inspected by: _____ Date: _____

Authority: _____ Field Book: _____

Beacon Diagram
Not to Scale

ABSTRACT OF OBSERVATIONS

Station	R.L. (metres)	Direction of Vert. Angle	Variance	Observed	Inst.	Observed	Date or
10							
<p>STATION T.S. Wilberforce Res. H.L. 15.67m Top of Mast (M.M.D) by Dept of Lands</p> <p>see Reverses for Location Diagram</p> <p>S.D. PIC 8/3 JAN 1976</p> <p>74.41m</p> <p>74.23m</p> <p>17.63m</p> <p>17.82m</p> <p>16.40m</p> <p>25.67m</p> <p>74.41m</p> <p>Leveling by Dept of Lands</p>							

All bearings corrected to true

All Verts corrected to ground

SE 1 HEAD OF CHURCH BLAIRNS

10. Diff. Ht. is m. below

14. Diff. Ht. is m. above

15. Diff. Ht. is m. below

16. Diff. Ht. is m. above

Prepared by: _____


Checked: _____

Date

Record of Station

STATION TS 5099 WILBERFORCE RES (P)

Owners Name.....
 Current Occupant.....
 Address.....
 Address.....
 Access.....

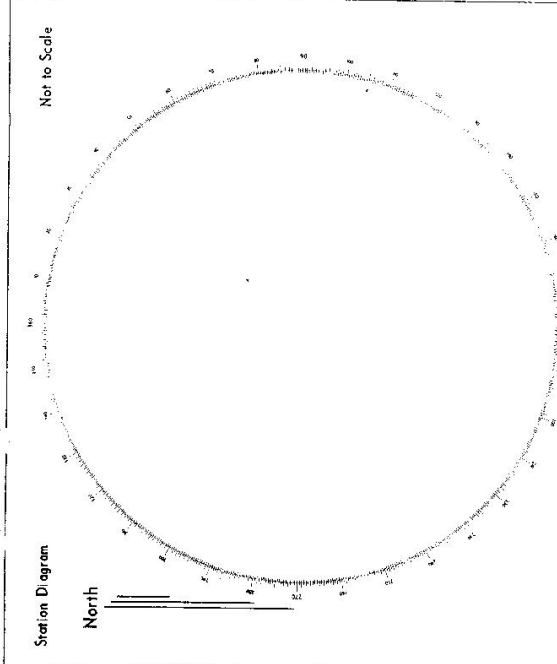

List of Observed Directions:-

Standpoint:		Standpoint:	
Station	Direction	Station	Direction

