

74-28

Trigonometrical Survey of N.S.W.

CENTRAL MAPPING AUTHORITY

Department of Lands

RECONNAISSANCE and MAINTENANCE REPORT

STATION **WONDALGA** TS **5105**

This Trig. Station has been:-

Note: Cross out word or words which do not apply

Co: **Wynyard**

Ph: **Wondalga**

Map Sheet: **TUMUT**

No: **8527**


Inspected by: **H.G. Hershman**

Date: **30-4-74**

Authority: **C.M.A.**

Field Book: **1209**

Beacon Diagram

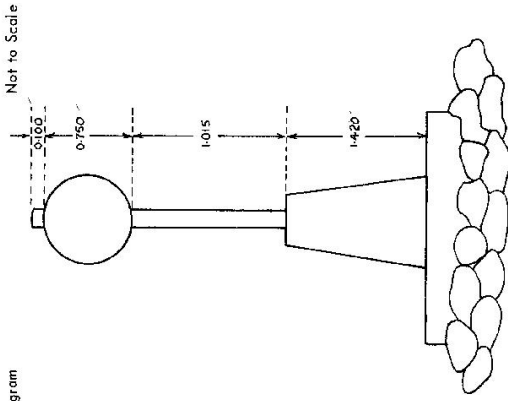

1. ~~Completely cleared to permit 360° vision to surrounding Trigs.~~  
*Completely cleared*
2. ~~Cleared by fence-bearing.~~ *from Trig. Mast.*
3. Trig. Mast & Vanes have been painted white & black respectively.
4. The Trig. was unpiled/~~not unpiled~~, dimensions now being:  
Description of mark... *Conc. 0.2 (Pillar Plate)* ... should be explicit, e.g. Steel plug, Brass plug, Bolt, G.I. Pipe  
Height of mark... *1.420* m <sup>above</sup> ~~below~~ *rock/concrete* G.L.  
Height of Top Vanes to Top Mark... *1.765* m. Diameter of Vanes (vertical)... *0.750* m.  
Height of Cairn... m. Diameter of Cairn... m.  
Length of Mast... *1.665* m. (approximate if not unpiled)
5. A. Trig. Plug... set in conc/~~rock~~ has been ~~placed~~... *3.025* m. bearing... *244* °M from Trig. Mast (Pillar)
6. A. Cu. Spike... set in conc/~~soil~~ has been ~~placed~~... *3.990* m. bearing... *296* °M from Trig. Mast
7. A. ... set in conc/~~soil~~ has been placed... m. bearing... °M from Trig. Mast
8. A. ... set in conc/~~rock~~ has been placed... m. bearing... °M from Trig. Mast
9. Connection Trig. Plug to Cu. Spike... *3.645* m. bearing... *342* °M
10. Connection... to... m. bearing... °M
11. Connection... to... m. bearing... °M
12. Connection... to... m. bearing... °M
13. Diff. Ht. ... Top of Pillar... is... *2.019* m. <sup>above</sup> ~~below~~ *Trig. Plug in conc.*
14. Diff. Ht. ... is... *2.220* m. <sup>above</sup> ~~below~~ *Cu. Spike in conc.*
15. Diff. Ht. ... Trig. Plug in conc. is... *0.210* m. <sup>above</sup> ~~below~~
16. Diff. Ht. ... is... m. <sup>above</sup> ~~below~~

Prepared by: *P. Johnston 14.5.74* Checked: *P. Johnston 22.5.74*

Noted on U.T.M. Card *Sally Clough 13/9/74* Checked *P. Johnston 13/10/74*

Date

Record of Station

STATION WONDALGA TS 5105

Owners Name.....J. RYAN.....

Current Occupant.....


Address.....

Address.....

Access 30-4-74


MILEAGE FEATURE

- 0.0 Intersection of Barlow & Adelong Sts at Gilmore. Proceed towards Barlow.
- 6.6 Wilsons Creek. Turn right onto Adelong Road.
- 9.7 Proceed towards Adelong. Turn right through gate. After turning through gate, house on left among pine trees.
- 9.8 Gate
- 10.2 Creek crossing - washed out
- 10.6 Through gate near pile of rocks.
- 11.0 Through fence. (Gate lying on track)
- 11.35 Washaway. Take lower track.
- 11.8 Drive over fallen fence. Head to top of ridge & follow it to Trig

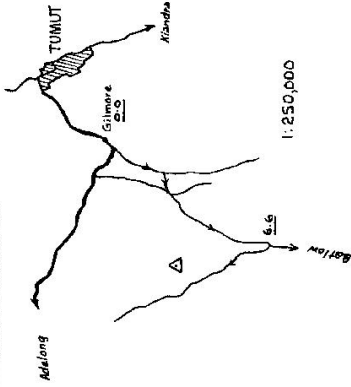

Station Diagram

North

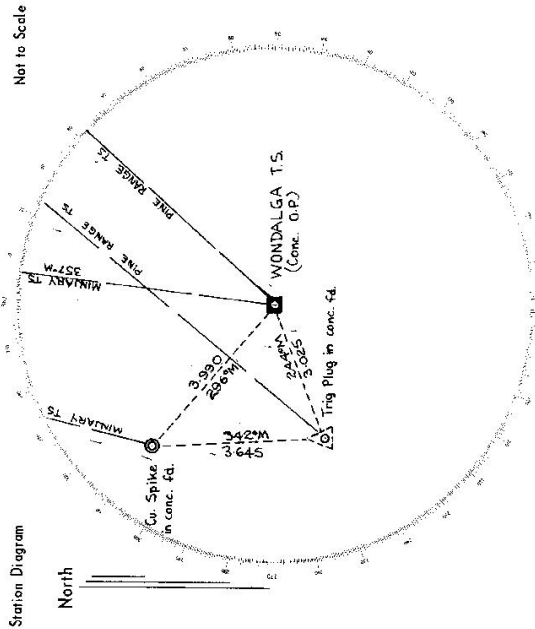

List of Observed Directions:-

Station	Direction	Station	Direction
MINJARY T.S.	359° 59' 40"	MINJARY T.S.	359° 59' 40"
PINE RANGE T.S.	34° 34' 07"	PINE RANGE T.S.	34° 33' 59"
Trig Plug in conc.	241° 13'	Conc. O.P.	6° 18'
Con. Spike in conc.	302° 03'	Con. Spike in conc.	248° 27'

Station	Direction	Station	Direction
Standpoint: Conc. O.P.		Standpoint: Trig Plug in conc.	

GEODETTIC SURVEY OF N.S.W.

CENTRAL MAPPING AUTHORITY

GEODETTIC STATION RECONNAISSANCE and MAINTENANCE REPORT

Description:

Note: Cross out word or words which do not apply

- Cleared by lanes bearing..... from Trig. Mast
- Mast & Vanes have been painted white & black respectively.
- The station/pillar was unpiled/not unpiled/constructed on..... dimensions now being: 19.....  
Description of mark..... should be explicit, e.g., S/Steel Pillar Plate, Steel Plug, Brass plug, Bolt, G.I. Pipe  
Height of mark.....m. <sup>above</sup>/<sub>below</sub> rock/concrete; Mark is.....m. <sup>above</sup>/<sub>below</sub> G.L.  
Height of Top Vanes to Top Mark/Pillar plate.....m. Diameter of Vanes (vertical).....m.  
Height of Cairn.....m. Diameter of ~~mark~~.....m. Name Plate found/not found/placed.  
Length of Mast.....m. (approximately if not unpiled)
- A..... set in conc/rock has been placed/found, bearing.....° M from Mast/Plug/Pillar
- A..... set in conc/rock has been placed/found, bearing.....° M from Mast/Plug/Pillar
- A..... set in conc/rock has been placed/found, bearing.....° M from Mast/Plug/Pillar
- A..... set in conc/rock has been placed/found, bearing.....° M from Mast/Plug/Pillar
- Action required:.....

STANDPOINT:

Mark	Direction	Horiz. Distance	Height Difference	Mark	Direction	Horiz. Distance	Height Difference
			above standpt.				above standpt.
			below standpt.				below standpt.
			above standpt.				above standpt.
			below standpt.				below standpt.
Prepared by: J. FAWCING

Checked: *[Signature]*

Noted on U.T.M. Card

8-5-82

Checked

STATION: **WONDALGA** No.: **5105**  
 MAP SHEET SCALE 1:250 000 **WAGGA WAGGA**  
 INSPECTED BY: **R. LAUIER** DATE: **25 Jan 82**  
 AUTHORITY: **C.M.A.** FIELD BOOK: **172**

St 2733-2 D. West, Government Printer

<p>Beacon Diagram</p>	<p>Not to Scale</p>	<p>STATION <b>WONJALGA.</b> TS <b>5105</b></p>	<p>Owner's Name: .....                  Address: .....                  Phone: .....                  Current Occupant: .....                  Address: .....                  Phone: .....                  ACCESS <b>25-1-1982</b>                  Access Report of <b>25/1/1982</b> was found suitable/unsuitable.</p> <p>On Turnout ↔ Barkow Road 18km From Teviot</p> <p>0.0 Intersection travel towards Adelong                  0.05 Cross Adelong Ch                  0.3 Veer right                  3.5 Cross over wooden bridge                  5.1 Turn right through iron gate at southern edge of stockyards                  (near house &amp; pine trees) - veer right and go around fence line                  then head straight uphill thru gap in contour bank.</p> <p>5.4 Through iron gate, straight uphill                  5.9 Cross gully                  6.0 Pass dam on left                  6.4 Through iron gate follow track                  6.8 " " "                  7.75 Veer left at wicket than head towards iron gate                  8.1 go through oil iron gate (white tyre on post) veer right on                  top of ridge                  8.75 Head north along ridge to station.                  (Went) (C/S)</p>
<p>This section to be completed by officer constructing pillar.</p> <p>Original station mark found/not found.</p> <p>Description of mark: .....</p> <p>Original beacon found/not found.</p> <p>Description of beacon: .....</p> <p>Height Top of Vanes to Top Mark .....m.</p> <p>Height of mark .....m. above G.L.                  below</p> <p>Diameter of Vanes .....m. Height of Cairn .....m.</p> <p>Original Beacon has/has not been destroyed by me.</p>		<p>Date</p> <p>Record of Station</p>	