

CENTRAL MAPPING AUTHORITY
Department of Lands

Trigonometrical Survey of N.S.W.
RECONNAISSANCE and MAINTENANCE REPORT

Previously known as Seal Rock L.H TS 5126
STATION *SEAL ROCK L.H (SUGARLOAF L.H.)*

7-4-08

This Trig. Station has been:-

Note: Cross out word or words which do not apply

1. Completely cleared to permit 360° vision to surrounding Trigs.
2. Cleared by lanes bearing..... from Trig. Mast
3. Trig. Mast & Vanes have been painted white & black respectively.
4. The Trig. was unpiled/not unpiled, dimensions now being: ^{original Station Trig. Mast & Vanes} should be explicitly, eg. Steel plug, Brass plug, Belt, G.L. Pipe

Description of mark.....
Height of mark..... m above rock/concrete m above below G.L.
Height of Top Vanes to Top Mark..... m. Diameter of Vanes (vertical)..... m.
Height of Cairn..... m. Diameter of Cairn..... m.

Length of Mast..... m. (approximate if not unpiled)

5. A..... set in conc/rock has been placed..... m. bearing.....°M from Trig. Mast
6. A..... set in conc/soil has been placed..... m. bearing.....°M from Trig. Mast
7. A..... set in conc/soil has been placed..... m. bearing.....°M from Trig. Mast
8. A..... set in conc/rock has been placed..... m. bearing.....°M from Trig. Mast

9. Connection..... to..... m. bearing.....°M

10. Connection..... to..... m. bearing.....°M

11. Connection..... to..... m. bearing.....°M

12. Connection..... to..... m. bearing.....°M

13. Diff. Ht. is..... m. above below

14. Diff. Ht. is..... m. above below

15. Diff. Ht. is..... m. above below

16. Diff. Ht. is..... m. above below

Co: *SIBULISTIER* Ph: *FOXTER*
Map Sheet: *FOXTER* No: *9433-III-S*
Inspected by: *P. MEN* Date: *19/4/77*
Authority: *C.M.A* Field Book: *1565*

Beacon Diagram
Not to Scale

Date	Record of Station

Checked

Noted on U.T.M. Card

Prepared by:

Checked:

STATION SEAL ROCK L.H. I SUGARLOAF L.H. I TS 5126


Owners Name.....
 Current Occupant.....
 Address.....
 Address.....

Access 19-4-1977

LN.

0.0 ✓ NORTH END OF SKIDDOE ALKDIS "MILL RIVER ON PACIFIC HWY. AT BULLHEAD LAH"
 4.0 ✓ T-INTERSECTION "NEWGATE" TAKEE TAKEE ROAD ON RIGHT TO "FOSTER"
 9.9 ✓ "BOULMABYTE" CREEK
 11.3 ✓ "BEHANG" CREEK
 238 ✓ PASS "WAGTON" ON LEFT ✓
 297 ✓ T-INTERSECTION, TURN RIGHT TO SEAL ROCK ✓
 319 ✓ END OF BITUMEN ✓
 343 ✓ PASS DIRT ROAD ON RIGHT ✓
 351 ✓ PASS DIRT ROAD ON LEFT ✓
 396 ✓ PASS CARRIVAN PARK ON RIGHT ✓
 401 ✓ PASS ROAD ON RIGHT ✓
 410.6 ✓ FOLLOW MAIN TRUCK UP HILL ✓
 41.3 ✓ BEOM CHATE, GO THRU ✓
 41.6 ✓ PARK VEHICLE. L.H. IS VISIBLE.
 I ACQUIRE PERMISSION FIRST FROM CARETAKER BEFORE VISITING THE L.H. ✓

FEATURES.

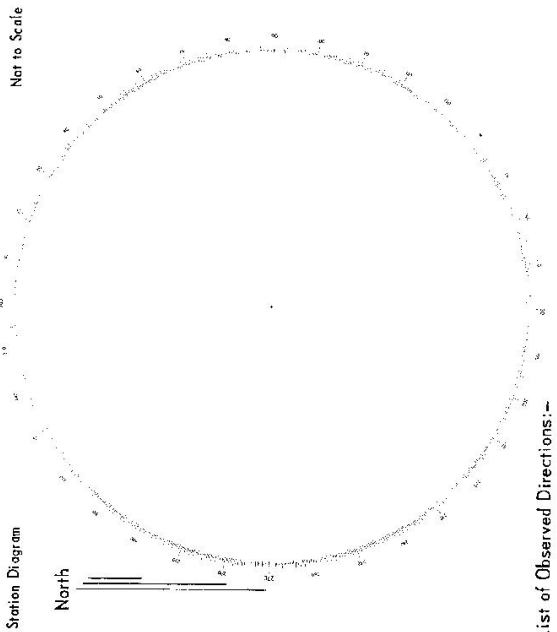

List of Observed Directions:-

Standpoint:	
Station	Direction

Standpoint:	
Station	Direction

14 pin