

GEODETTIC SURVEY OF N.S.H.K.

CENTRAL MAPPING AUTHORITY

GEODETTIC STATION RECONNAISSANCE and MAINTENANCE REPORT

STATION: SOUTH BLACK RANGE No.: 5130

MAP SHEET SCALE 1:250 000 CANBERRA

INSPECTED BY: G. C. HANNA DATE: 1/5/79

AUTHORITY: C.M.A. FIELD BOOK:

- Description:
1. Cleared by lanes bearing..... *Note: Cross out word or words which do not apply*..... from Trig. Mast
2. Mast & Vanes have been painted white & black respectively.
3. The station/pillar was unpiled/not unpiled/constructed on..... 19..... dimensions now being:  
 Description of mark..... should be explicit, e.g., S/Steel Pillar Plate-Steel plug, Brass plug, Bolt, G.I. Pipe  
 Height of mark..... m. <sup>above</sup> rock/concrete; Mark is..... m. <sup>above</sup> G.L.  
 Height of Top Vanes to Top Mark/Pillar plate..... m. Diameter of Vanes (vertical)..... m.  
 Height of Cairn..... m. Diameter of Cairn..... m. Name Plate found/not found/placed.  
 Length of Mast..... m. (approximate if not unpiled)
4. A..... set in conc/rock has been placed/found, bearing..... ° M from Mast/Plug/Pillar
5. A..... set in conc/rock has been placed/found, bearing..... ° M from Mast/Plug/Pillar
6. A..... set in conc/rock has been placed/found, bearing..... ° M from Mast/Plug/Pillar
7. A..... set in conc/rock has been placed/found, bearing..... ° M from Mast/Plug/Pillar
8. Action required:.....


STANDPOINT:

Mark	Direction	Horiz. Distance	Height Differences	Mark	Direction	Horiz. Distance	Height Difference
			above standpt.				above standpt.
			below				below
			above standpt.				above standpt.
			below				below

Prepared by: *G. Hanna* 8/5/79

Checked: *G. Hanna*

ST 2733-1

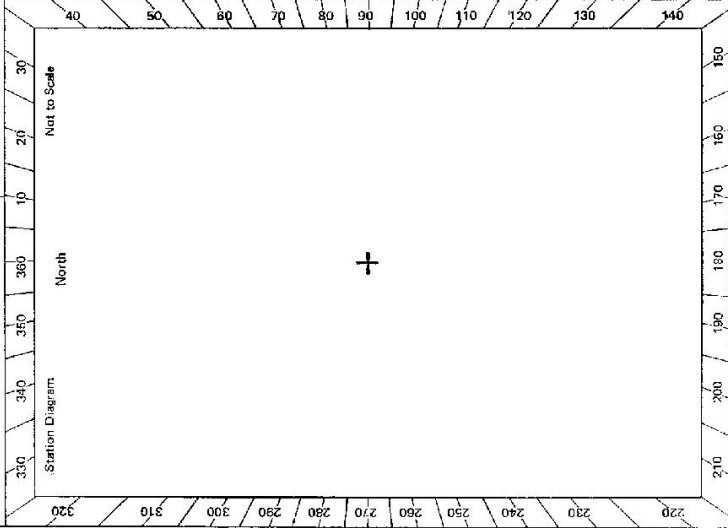

G

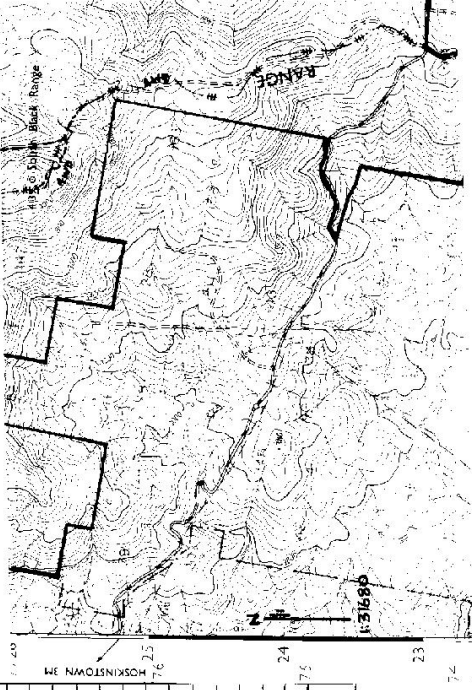St 2733-2 D West, Government Printer Beacon Diagram	STATION SOUTH BLACK RANGE IS 5130	Owner's Name: ..... Address: ..... Phone: ..... Current Occupant: ..... Address: ..... Phone: .....	<p style="text-align: center;"><b>ACCESS</b></p> <p>Access Report of 15/11/1971 was found suitable/unsuitable.</p>  <p>Cairn, most 3 vanes fl.                  Trig on 6m high boulder                  Drive to within 50m of                  trig                  Access to trig by crude                  wooden ladder                  SSM in rock fl 2m from                  trig to the S.E.                  Medium to heavy clearing                  required.</p> <p style="text-align: right;">Braidwood                  Abt 32km</p>
Not to Scale		Date ..... Record of Station ..... ..... .....	
This section to be completed by officer constructing pillar. Original station mark found/not found. Description of mark: ..... Original beacon found/not found. Description of beacon: ..... Height Top of Vanes to Top Mark .....m. Height of mark .....m. above rock/comp .....m. above G.L. Diameter of Vanes .....m. Height of Cairn .....m. Original Beacon has/has not been destroyed by me.			