

GEODETIC SURVEY OF N.S.W.

CENTRAL MAPPING AUTHORITY


GEODETIC STATION RECONNAISSANCE and MAINTENANCE REPORT

STATION: NM C 134 No.: 5144

MAP SHEET SCALE 1:250 000 MILDURA S154-11

INSPECTED BY: G. HANNA DATE: 16/3/83

AUTHORITY: C.M.A. FIELD BOOK:

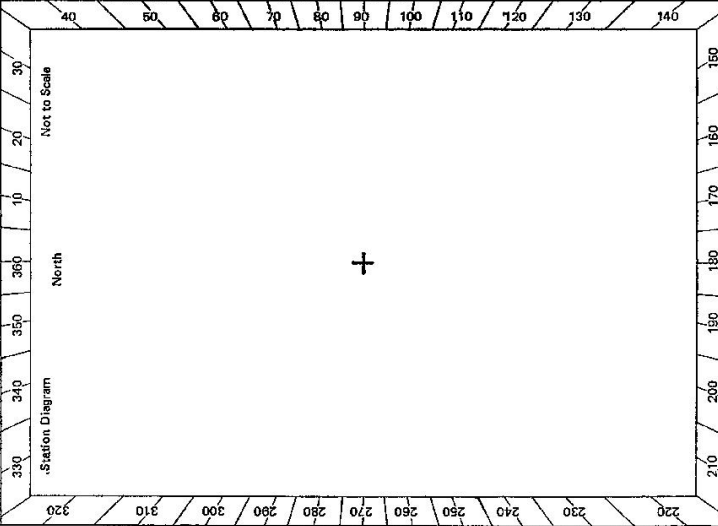

- Description:
- Cleared by lanes bearing.....
Note: Cross out word or words which do not apply
 - Mast & Vanes have been painted white & black respectively.
 - The station/pillar was unpiled/not unpiled/constructed on.....19....., dimensions now being:
Description of mark.....should be explicit, e.g., S/Steel Pillar Plate, Steel plug, Brass plug, Bolt, G.I. Pipe
Height of mark.....m.....^{above} rock/concrete; Mark is.....m.....^{above} G.L.
 - Height of Top Vanes to Top Mark/Pillar plate.....m. Diameter of Vanes (vertical).....m.
 - Height of Cairn.....m. Diameter of Cairn.....m. Name Plate found/not found/placed,
Length of Mast.....m. (approximate if not unplaced)
 - A.....set in conc/rock has been placed/found, bearing.....°M from Mast/Plug/Pillar
 - A.....set in conc/rock has been placed/found, bearing.....°M from Mast/Plug/Pillar
 - A.....set in conc/rock has been placed/found, bearing.....°M from Mast/Plug/Pillar
 - A.....set in conc/rock has been placed/found, bearing.....°M from Mast/Plug/Pillar
 - Action required:.....

STANDPOINT:			
Mark	Direction	Horiz. Distance	Height Difference
			above standpt.
			below standpt.
			above standpt.
			below standpt.
Prepared by:
Checked:
Noted on U.T.M. Card

