

CENTRAL MAPPING AUTHORITY

GEODETTIC SURVEY OF N.S.W.

GEODETTIC STATION RECONNAISSANCE and MAINTENANCE REPORT

Description:

Note: Cross out word or words which do not apply

1. Cleared by latest bearing. Natural breaks in trees; could be widened from top of Mast
2 Mast & Vane have been painted white & black respectively. No mast or vane
3. The station/pillar was unpiled/~~not~~ constructed on 10 dimensions now being:
Description of mark Slip in soil should be explicit, e.g., S/Steel Pillar Plate, Steel plug, Brass plug, Bolt, G.I. Pipe
Height of mark 0.1 m. soil above rock/feature below Mark is 0.1 m. above G.L.
Height of Top Vane to Top Mark/Pillar plate 0.5 m. Diameter of Vane (vertical) 0.7 m. Name Plate found/~~not found~~/placed.
Length of Mast 0.5 m. (approximate if not unipiled)
4. A set in conc/rock has been placed/found, bearing 0° M from Mast/Plug/Pillar
5. A set in conc/rock has been placed/found, bearing 0° M from Mast/Plug/Pillar
6. A set in conc/rock has been placed/found, bearing 0° M from Mast/Plug/Pillar
7. A set in conc/rock has been placed/found, bearing 0° M from Mast/Plug/Pillar
8. Action required: Satellite marks; Cairn, Mast, Vane, & pillar; if required

STANDPOINT:


STANDPOINT:

Mark	Direction	Horiz. Distance	Height Difference	Mark	Direction	Horiz. Distance	Height Difference
			above standpt.				above standpt.
			below standpt.				below standpt.
			above standpt.				above standpt.
			below standpt.				below standpt.
Prepared by: I.W. Robins 4/3/18Checked: 4/3/18

Noted on U.T.M. Card

S. 2783-1

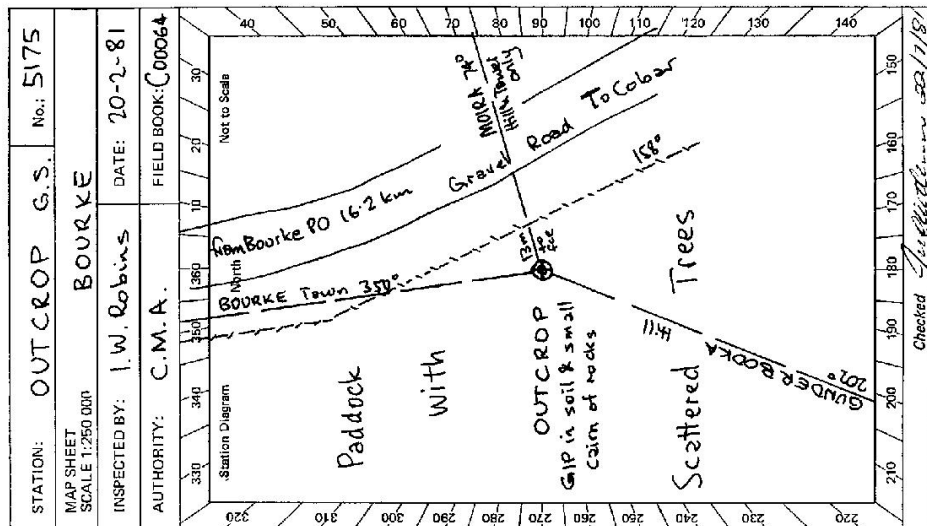

STATION

OUTCROP

5175

Owner's Name: *Va. K. K. K.*

Current Occupant:

Address:

Phone:

ACCESS

26-2-1981

Access Report of: *1981* was found *unsuitable*/unsuitable.

00

Boutke Post Office, head east along Oxley St.

0.1

Turn right at Police Station into Mitshell thwy.

0.6

Pass Mitchell thwy to left, continue on along Coblar Road and across rail way

3.7

Pass turn off to Wikanniz & Louth to right

16.2

At bend in road a small rice stop.

OUTCROP

is in small cairn of rocks 13m West of fence along Western side of road.

Date

Record of Station

Beacon Diagram

Not to Scale

This section to be completed by officer constructing pillar.

Original station mark found/not found.

Description of mark:

Original beacon found/not found.

Description of beacon:

Height Top of Vanes to Top Mark

Height of mark

Diameter of Vanes

Original Beacon has/not been destroyed by me.