





NON-GEODETIC


No.: TS 5177

STATION: *OWENS SOUTH*

MAP SHEET SCALE 1:250 000 *BATHURST*

INSPECTED BY: *P.Potts* DATE: *25.6.85*

AUTHORITY: *C.M.A.* FIELD BOOK: *282*

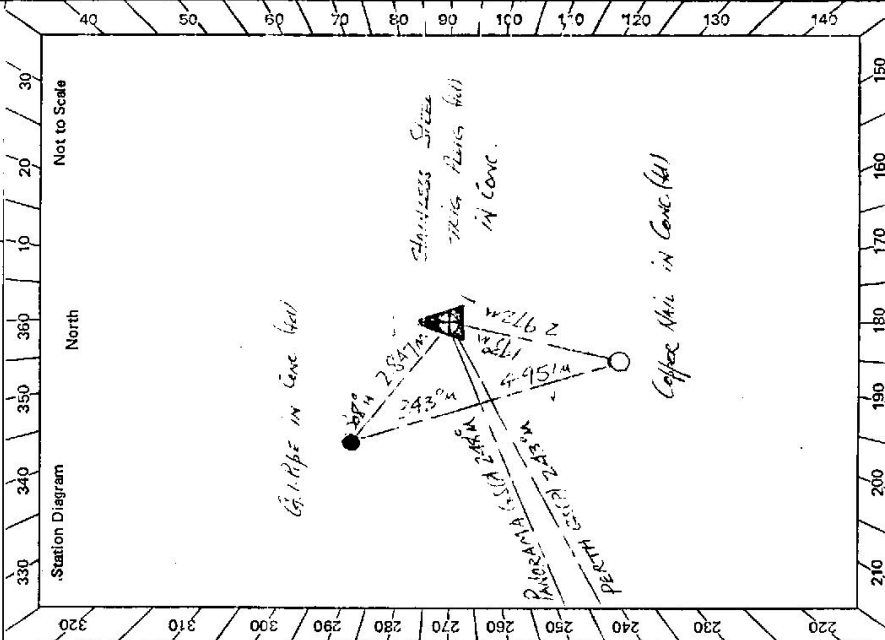

CENTRAL MAPPING AUTHORITY  
 GEODETIC SURVEY OF N.S.W.  
 GEODETIC STATION RECONNAISSANCE AND MAINTENANCE REPORT

Description: *237m to 284m* Note: Cross out word or words which do not apply

1. Cleared by lanes bearing *237m to 284m* from Trig. Mast
  2. Mast & Vanes have been painted white & black respectively. ✓
  3. The station/~~marker~~ was unpiled/~~not replaced~~ on *25.6.85*, dimensions now being: *Steel Trig. Pile* should be explicit, e.g., S/Steel Pillar Plate, Steel plug, Brass plug, Bolt, G.I. Pipe
- Description of mark: *Steel Trig. Pile* should be explicit, e.g., S/Steel Pillar Plate, Steel plug, Brass plug, Bolt, G.I. Pipe
- Height of mark *0.055* m. above ~~rock~~ concrete; Mark is *0.055* m. above G.L.
- Height of Top Vanes to Top Mark/~~Plate~~ *3.600* m. Diameter of Vanes (vertical) *1.015* m.
- Height of Cairn. *1.350* m. Diameter of Cairn. *2.500* m. Name Plate found/not ~~found~~/placed.
- Length of Mast *1.350* m. (approximate if not unpiled)
4. A. *G.I. Pipe* set in conc/~~rock~~ has been ~~placed~~/found, bearing *338*° M from ~~base~~/Plug/~~pillar~~
  5. A. *Copper Nail* set in conc/~~rock~~ has been ~~placed~~/found, bearing *193*° M from ~~base~~/Plug/~~pillar~~
  6. A. *Steel Trig. Pile* set in conc/rock has been placed/found, bearing *128*° M from Mast/Plug/Pillar
  7. A. *Well 2* set in conc/rock has been placed/found, bearing *128*° M from Mast/Plug/Pillar

8. Action required: *PAVE CONCRETE PAVEMENT & SOME CLEARINGS*


STANDPOINT: *SHANKLESS STEEL TRIG. PILE* STANDPOINT: *COPPER NAIL*

| Mark                    | Direction        | Horiz. Distance | Height Difference | Mark                    | Direction        | Horiz. Distance      | Height Difference |
|-------------------------|------------------|-----------------|-------------------|-------------------------|------------------|----------------------|-------------------|
| <i>PERTH G.S.P.</i>     | <i>0 00 00</i>   |                 | above standpt     | <i>PERTH G.S.P.</i>     | <i>0 00 00</i>   |                      | above standpt     |
| <i>PANDORAMA G.S.P.</i> | <i>4 57 50</i>   |                 | above standpt     | <i>PANDORAMA G.S.P.</i> | <i>4 57 40</i>   |                      | above standpt     |
| <i>G.I. Pipe</i>        | <i>64 44 30</i>  | <i>2.847</i>    | above standpt     | <i>G.I. Pipe</i>        | <i>67 14 10</i>  | <i>4.951</i>         | above standpt     |
| <i>Copper Nail</i>      | <i>108 11 00</i> | <i>2.972</i>    | above standpt     | <i>STEEL TRIG. PILE</i> | <i>128 09 40</i> | <i>2.973 to 4.39</i> | above standpt     |
|                         |                  |                 | below standpt     |                         |                  |                      | below standpt     |
|                         |                  |                 | above standpt     |                         |                  |                      | above standpt     |
|                         |                  |                 | below standpt     |                         |                  |                      | below standpt     |

Prepared by: *P.Potts* 27-6-85. Checked: *H. Khan* Noted on U.T.M. Card

SI 2733-2 D. West, Government Printer

STATION OUEKS SOUTH GS TS 5177

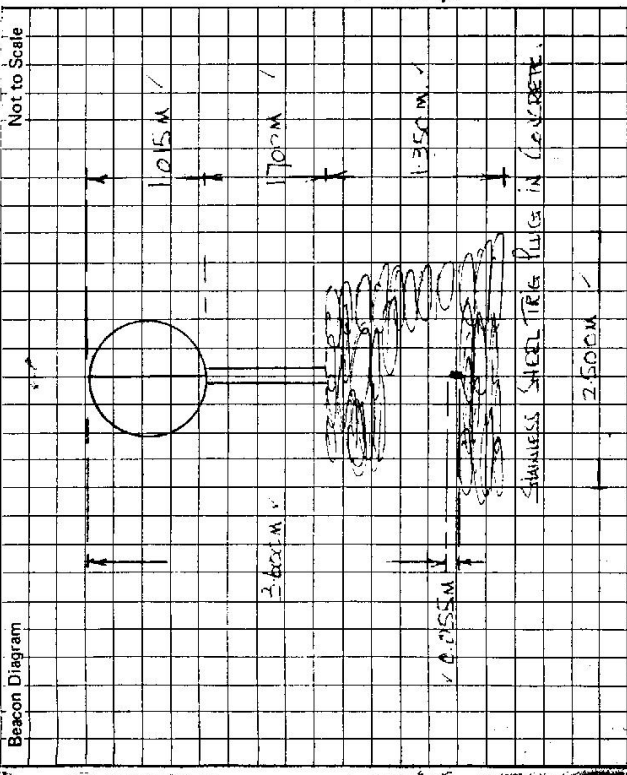

Owner's Name: .....  
 Address: .....  
 Phone: .....  
 Current Occupant: .....  
 Address: .....  
 Phone: .....

ACCESS

Access Report of 25.6.1985 was found suitable/unsuitable.

FEATURE  
 0.00 POST OFFICE KELSO HEAD TOWARDS SYDNEY  
 17.19 TURN LEFT SIGN YETHOLME  
 20.68 TURN LEFT ONTO MACABEES ROAD.  
 21.88 TURN LEFT ONTO MT HOMER FOREST ROAD.  
 22.40 TURN RIGHT  
 22.63 TURN RIGHT  
 22.97 TURN LEFT ONTO MT HOMER FOREST ROAD - FOLLOW THIS  
 ROAD ALONG EDGE OF PINE FOREST.  
 26.35 TURN LEFT OF MAIN ROAD ONTO TRACK.  
 26.61 PASS TRACK ON LEFT - PASS THROUGH OLD FENCE  
 26.98 OUEKS SOUTH G.S. ON RIGHT OF TRACK.

| Date | Record of Station |
|------|-------------------|
|      |                   |
|      |                   |
|      |                   |

This section to be completed by officer constructing pillar.

Original station mark found/not found.

Description of mark: .....

Original beacon found/not found.

Description of beacon: .....

Height Top of Vanes to Top Mark.....m.

Height of mark.....m. above G.L. below

Diameter of Vanes .....m.

Original Beacon has/has not been destroyed by me.

Height of Cairn .....m.