

CENTRAL MAPPING AUTHORITY

Trigonometrical Survey of N.S.W.

TINGARINGY.

TS 5195

Department of Lands

RECONNAISSANCE and MAINTENANCE REPORT

STATION INGA RING

This Trig. Station has been:

Note: Cross out word or words which do not apply

- 1. Completely cleared to permit 360° vision to surrounding Trigs.
- 2. Cleared by lanes bearing..... from Trig. Mast
- 3. Trig. Mast & Vanes have been painted white & black respectively.
- 4. The Trig. was unpiled/~~un~~unpiled, dimensions now being: 0.85 m above G.L. Description of mark..... BRASS TRIG. PLUG..... should be explicit, e.g. Steel plug, Brass plug, Bolt, G.I. Pipe
 Height of mark..... m above rock/concrete..... m below G.L.
 Height of Top Vanes to Top Mark 4.0 m. Diameter of Vanes (vertical) 0.20 m.
 Height of Cairn..... m. Diameter of Cairn..... m.

- 5. A..... set in conc./rock has been placed..... m. bearing.....°M from Trig. Mast
- 6. A. GIRPE..... set in ~~conc~~conc./soil has been placed...0.85 m. bearing...132°M.....°M from Trig. Mast
- 7. A..... set in conc./soil has been placed..... m. bearing.....°M from Trig. Mast
- 8. A..... set in conc./rock has been placed..... m. bearing.....°M from Trig. Mast

- 9. Connection..... to..... m. bearing.....°M
- 10. Connection..... to..... m. bearing.....°M

- 11. Connection..... to..... m. bearing.....°M
- 12. Connection..... to..... m. bearing.....°M

- 13. Diff. Ht. GIRPE..... is 0.924 m. ^{above}..... BRASS TRIG. PLUG..... _{below}

- 14. Diff. Ht. is..... m. ^{above}..... _{below}
- 15. Diff. Ht. is..... m. ^{above}..... _{below}
- 16. Diff. Ht. is..... m. ^{above}..... _{below}

Prepared by: R. LAUNDER Checked: Alan Winstanley Noted on U.T.M. Card


Co: _____ Ph: _____

Map Sheet: MLM B/LA No: 8624 - S

Inspected by: A WOODRUFF D. LAUNDER Date: 19-2-77

Authority: CENTRAL MAPPING Field Book: 1531

Beacon Diagram Not to Scale

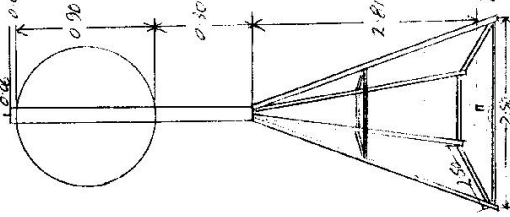

Date _____ Record of Station _____

19/77 BRASS PLUG IN CONC ABOVE
TRIG. CLEARED FOR 30" VISION
TRIG. NEED PAINTING

Checked

