

LAND INFORMATION CENTRE

GEODETTIC SURVEY OF N.S.W.

GEODETTIC STATION RECONNAISSANCE and MAINTENANCE REPORT

Description:

1. Cleared by Janes bearing..... from Trig. Mast
 Note: *Cross out word or words which do not apply*

2. Mast & Vanes have been painted white & black respectively.

3. The station/pillar was unpiled/not unpiled/constructed on..... 19....., dimensions now being:

Description of mark..... should be explicit, e.g., S/Steel Pillar Plate, Steel plug, Brass plug, Bolt, G.I. Pipe

Height of mark.....^{above} m. ^{below} m. Mark is.....^{above} m. ^{below} m. G.L.

Height of Top Vanes to Top Mark/Pillar plate m. Diameter of Vanes (vertical)..... m.

Height of Cairn..... m. Diameter of Cairn..... m. Name Plate found/not found/placed.

Length of Mast m. (approximate if not unpiled)

4. A..... set in conc/rock has been placed/found, bearing.....°M from Mast/Plug/Pillar

5. A..... set in conc/rock has been placed/found, bearing.....°M from Mast/Plug/Pillar

6. A..... set in conc/rock has been placed/found, bearing.....°M from Mast/Plug/Pillar

7. A..... set in conc/rock has been placed/found, bearing.....°M from Mast/Plug/Pillar

8. Action required:.....

STANDPOINT:

STANDPOINT:

Mark	Direction	Horiz. Distance	Height Difference	Mark	Direction	Horiz. Distance	Height Difference
			above standpt.				above standpt.
			below				below
			above standpt.				above standpt.
			below				below
Prepared by  5/8/96. Checked:


Noted on U.T.M. Card

Checked

STATION: *NM 8 271 (OLD)* No.: *5209*
 MAP SHEET SCALE 1:250 000 *BULLOO* SH *54-4*
 INSPECTED BY: *M J Morrison* DATE: *24-7-96*
 AUTHORITY: *L.I.C.* FIELD BOOK: *--*

Station Diagram: North
 Not to Scale

ALL MARKS FOUND OK
RM 2: CONCRETE EXPOSED
BY APPROX 30cm.
ACCESS OVER.

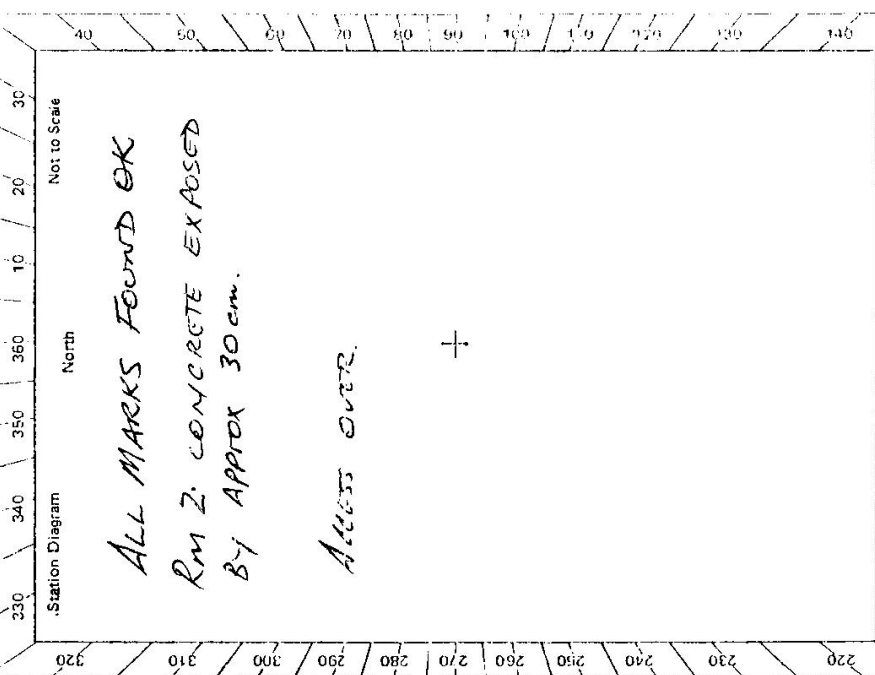

STATION NMB 271 (OLD) 5209

2733-2 D. West, Government Printer

Beacon Diagram	No: to Scale
Owner's Name:	
Address:	
Phone:	
Current Occupant:	
Address:	
Phone:	
ACCESS	
Access Report of	
0.00 HAMILTON GATE ON NSW-OLD	
0.1 GATE	
0.9 GATE	
5.4 GATE	
16.1 GATE (NMB316 ON RIGHT)	
22.8 NMB317 ON LEFT NEAR WHITEWOOD TREE	
* 27.8 GO THROUGH GATE IN BORDER FENCE HEAD WEST ON OLD SIDE OF F.L.	
36.2 TURN RIGHT AT TOP OF SAND RIDGE	
36.3 NMB 271	
* 27.8 IF SERVICE GATE LOCKED AT 27.8 - KEEP HEADING WEST ON NSW SIDE OF FENCE	
36.2 NMB271 ON OLD SIDE 100M NORTH OF FENCE	
46.2 TURN RIGHT THROUGH 'BARBARA GATE' + HEAD EAST ALONG OLDSIDE OF FENCE	
56.2 TURN LEFT AT TOP OF SAND RIDGE	
56.3 NMB 271	
<p>This section to be completed by officer constructing pillar.</p> <p>Original station mark found/not found.</p> <p>Description of mark:</p> <p>Original beacon found/not found.</p> <p>Description of beacon:</p> <p>Height Top of Vanes to Top Markm.</p> <p>Height of markm. above G.L. below</p> <p>Diameter of Vanesm. Height of Cairnm.</p> <p>Original Beacon has/has not been destroyed by me.</p>	
Date	Record of Station

24/7/96.