

CENTRAL MAPPING AUTHORITY GEODETIC SURVEY OF N.S.W.

GEODETIC STATION RECONNAISSANCE AND MAINTENANCE REPORT

Description:

1. Cleared by lanus bearing... *Note: Cross out word or words which do not apply*  
 No observations for SATELLITE SURVEY.
2. Mast & Vanes have been painted white & black respectively.
3. The station/~~pillar~~ was unpiled/~~not replaced/constructed~~ on... 19.8.9, dimensions now being:  
 13mm diam.

Description of mark... should be explicit, e.g., S/Steel Pillar Plate, Steel plug, Brass plug, Bolt, G.I. Pipe

Height of mark... Level... Mark is... <sup>above</sup> <sub>below</sub> concrete; <sup>above</sup> <sub>below</sub> G.L.

Height of Top Vanes to Top Mark/Pillar plate... Diameter of Vanes (vertical)...  
 Height of Cairn... Diameter of Cairn... Name Plate ~~found~~/not found/~~placed~~.

Length of Mast... (approximate if not unpiled)


4. A... ~~COPPER~~... set in conc/rock has been ~~placed~~/found, bearing... °M from Mast/Plug/Pillar
5. A... ~~COPPER~~... set in conc/rock has been ~~placed~~/found, bearing... °M from Mast/Plug/Pillar
6. A... ~~COPPER~~... set in conc/rock has been ~~placed~~/found, bearing... °M from Mast/Plug/Pillar
7. A... set in conc/rock has been ~~placed~~/found, bearing... °M from Mast/Plug/Pillar

8. Action required: ~~REPLACE SATELLITE MARKS~~... REPLACEMENT... S.VANES

STANDPOINT:

Mark	Direction	Horiz. Distance	Height Difference	Mark	Direction	Horiz. Distance	Height Difference
			above standpt				above standpt
			below				below
			above standpt				above standpt
			below				below
Prepared by: D. KAIN. Checked: Noted on U.T.M. Card

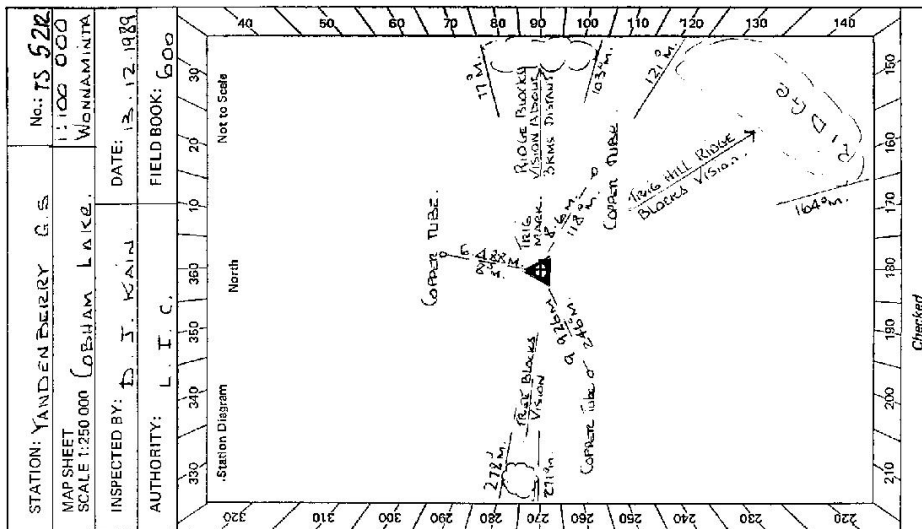



STATION <b>YANDBERRY G.S. TS 5212</b>	Owner's Name: <b>MR PETER WESTON</b> Address: <b>MARRAPINNA STATION</b> <b>VIA BACKEN HILL</b> Phone: .....	Current Occupant: ..... Address: ..... Phone: .....	
D. J. KAIN Access Report of 13/11/1981 was found suitable/unsuitable. ACCESS <b>13-12-89 FOUND SUITABLE</b>			
Beacon Diagram: <div style="text-align: center;"> </div>			
This section to be completed by officer constructing pillar.			
Original station mark found/not found.			
Description of mark: .....			
Original beacon found/not found.			
Description of beacon: .....			
Height Top of Vanes to Top Mark: .....m.			
Height of mark: .....m. above G.L. below			
Diameter of Vanes .....m. Height of Cairn .....m.			
Original Beacon has/has not been destroyed by me.			
			Date ..... Record of Station .....

