

GEODETTIC SURVEY OF N.S.K.

CENTRAL MAPPING AUTHORITY

GEODETTIC STATION RECONNAISSANCE and MAINTENANCE REPORT

Description: *Note: Cross out word or words which do not apply*

- Cleared by lanes bearing..... from Trig. Mast
- Mast & Vanes have been painted white & black respectively.
- The station/~~marker~~ ^{BRASS SURVEY} was ~~erected~~/not unplied/~~constructed~~ on..... 19..... dimensions now being:
Description of mark..... ^{BRASS SURVEY} should be explicit, e.g., S/Steel Pillar Plate, Steel plug, Brass plug, Bolt, G.I. Pipe
Height of mark..... ^{above} ~~below~~ ^{height} ~~mark~~ is ^{AT}.....m. ^{above} ~~below~~ ^{G.L.} ~~mark~~
Height of Top Vanes to Top Mark/Pillar plate.....m. Diameter of Vanes (vertical).....m.
Height of Cairn.....m. Diameter of Cairn.....m. Name Plate ~~found~~/not found/~~placed~~:
Length of Mast.....m. (approximate if not unplied)

STANDPOINT: **YELTA BRASS PEGS S218-0**


Mark	Direction	Horiz. Distance	Height Difference
DARETON G.S.	0° 00' 00"		above standpt.
YELTA G.I. Pipe S218-7	0° 16' 33"	22.418	above standpt.
YELTA G.I. Pipe S218-6	5° 47' 56"	22.455	below standpt.

STANDPOINT: **YELTA G.I. PIPE S218-7**

Mark	Direction	Horiz. Distance	Height Difference
ASCHENDALE G.S. (VIC)	0° 00' 00"	22.413	above standpt.
YELTA BRASS PEGS	91° 51' 52"		below standpt.
DARETON G.S.	179° 43' 8"		below standpt.
YELTA G.I. PIPE (S218-6)	271° 43' 00"	2.166	above standpt.
DARETON G.S.	197° 48' 53"		below standpt.

Prepared by: *[Signature]* Checked: *[Signature]* Noted on U.T.M. Card

S. 2753-1

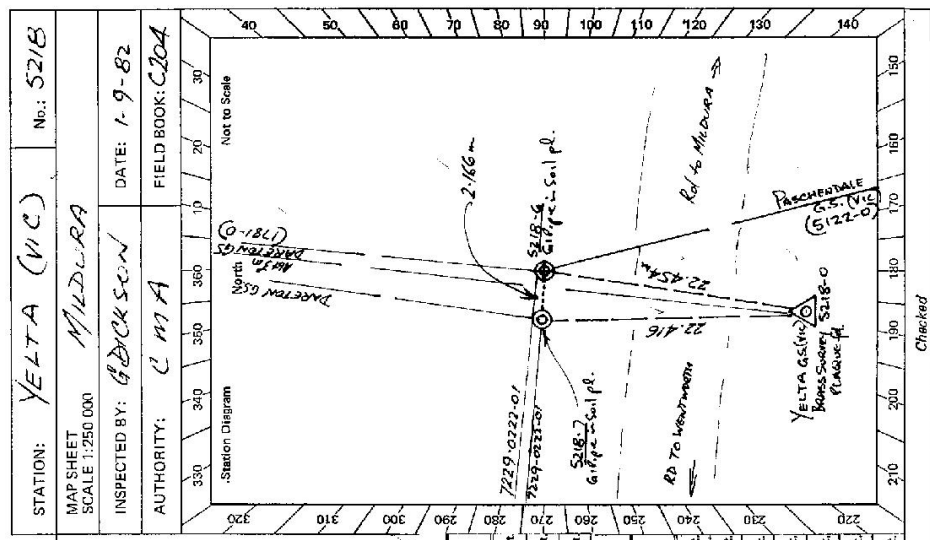

Checked

LAND INFORMATION CENTRE

GEODETIC SURVEY OF N.S.W.

GEODETIC STATION RECONNAISSANCE and MAINTENANCE REPORT

Description:

Note: Cross out word or words which do not apply

1. Cleared by vanes bearing..... from Trig. Mast
2. Mast & Vanes have been painted white & black respectively.
3. The station/pillar was unplied/not unplied/constructed on.....19....., dimensions now being:
Description of mark.....should be explicit, e.g, S/Steel/Pillar Plate, Steel plug, Brass plug, Bolt, G.I. Pipe
Height of mark.....m. above rock/concrete; Mark is.....m. above G.L.
Height of Top Vanes to Top Mark/Pillar plate.....m. Diameter of Vanes (vertical).....m.
Height of Cairn.....m. Diameter of Cairn.....m. Name Plate found/not found/placed.
Length of Mast.....m. (approximate if not unplied)
4. A. **SSM 72915**.....set in conc/rock has been placed/found, bearing.....**S**.....°M from Mast/Plug/Pillar
5. A.....set in conc/rock has been placed/found, bearing.....°M from Mast/Plug/Pillar
6. A.....set in conc/rock has been placed/found, bearing.....°M from Mast/Plug/Pillar
7. A.....set in conc/rock has been placed/found, bearing.....°M from Mast/Plug/Pillar


8. Action required:.....

STANDPOINT: BRASS PLAQUE		STANDPOINT: SSM 72915					
Mark	Direction	Horiz. Distance	Height Difference	Mark	Direction	Horiz. Distance	Height Difference
ARLTON	0 00 00		above standpt. below	DALETON	0 00 00		above standpt. below
SM 72915	0 00 05	27.23	0.307	VELTA	180 00 00	27.21	0.311
			above standpt. below				above standpt. below
			above standpt. below				above standpt. below
			above standpt. below				above standpt. below
			above standpt. below				above standpt. below

Prepared by: *L.L.M.*

Checked: **B. HES** 9 10 91

Checked

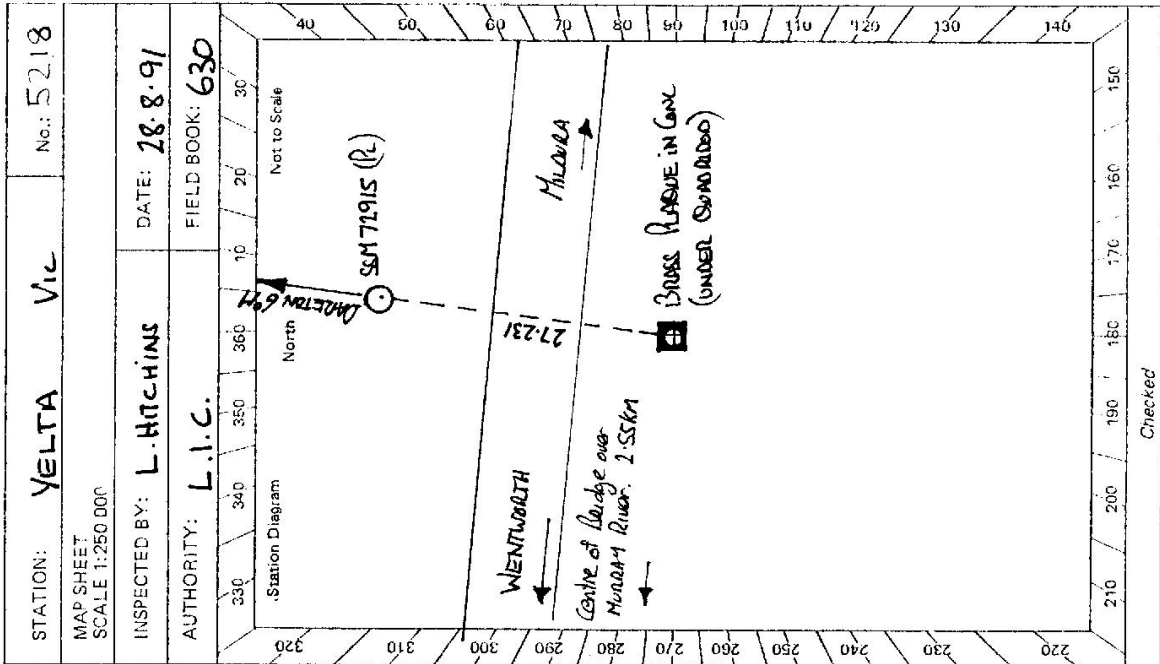

STATION: **VELTA** Vic No.: **5218**

MAP SHEET SCALE 1:250 000

INSPECTED BY: **L. HITCHINS** DATE: **28.8.91**

AUTHORITY: **L.I.C.** FIELD BOOK: **630**