

GEODETIC SURVEY OF NSW

CENTRAL MAPPING AUTHORITY

GEODETIC STATION RECONNAISSANCE and MAINTENANCE REPORT

Description:  
 1. ~~Cleared by lanes bearing~~..... Note: Cross out word or words which do not apply  
 from ~~Fig. Mast~~.....

2. ~~Mast & Vanes have been painted white & black respectively.~~

3. The station/~~pillar~~ was ~~erected~~/not unplied/~~reconstructed~~ on..... 10..... dimensions now being:

Description of mark..... should be explicit, e.g. S/Steel Pillar Plate, Steel plug, Brass plug, Bolt, G.I. Pipe

Height of mark..... m. <sup>above</sup>/<sub>below</sub> rock/concrete: Mark is..... m. <sup>above</sup>/<sub>below</sub> G.L.

Height of Top Vanes to Top Mark/Pillar plate..... m. Diameter of Vanes (vertical)..... m.

Height of Cairn..... m. Diameter of Cairn..... 2.5..... m. ~~Name Plate found/not found/placed.~~

Length of Mast..... NA (approximate if not unplied)

4. A..... set in conc/rock has been placed/found, bearing..... °M from Mast/Plug/Pillar

5. A..... set in conc/rock has been placed/found, bearing..... °M from Mast/Plug/Pillar

6. A..... set in conc/rock has been placed/found, bearing..... °M from Mast/Plug/Pillar


7. A..... set in conc/rock has been placed/found, bearing..... °M from Mast/Plug/Pillar

8. Action required: ~~Re-piling~~..... ~~settable~~ for ~~pillar~~..... ~~2 days cleaning for 360° view~~.....

STANDPOINT:

Mark	Direction	Horiz. Distance	Height Difference	Mark	Direction	Horiz. Distance	Height Difference
			above standpt.				above standpt.
			below				below
			above standpt.				above standpt.
			below				below
STANDPOINT:

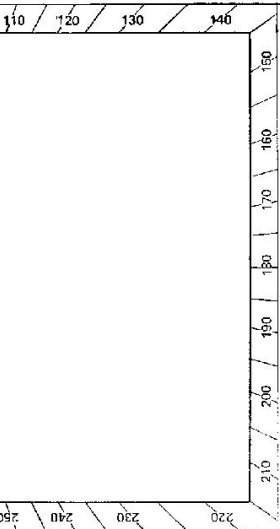

Prepared by: Ian W. Robins 11/11/78

Checked: C.M.A.

FIELD BOOK:

Checked

St. 2753-2 D. West, Government Printer Beacon Diagram	Not to Scale Grid area with handwritten note: <i>Cairn only</i>	STATION <b>YOUNGARA G.S. B 5219</b> Owner's Name: ..... Address: ..... Phone: ..... Current Occupant: ..... Address: ..... Phone: ..... ACCESS <b>11/11/1978</b> Access Report of ..... Note: <i>Access Report of ..... was found suitable/unavailable.</i>	<p>① from Ungarie P.O. take Nared from Road 25 km.                  ② Turn right into Connellans Lane follow for 228 km to track leading off to East at bend in lane.</p>
		This section to be completed by officer constructing pillar. Original station mark found/not found. Description of mark: ..... Original beacon found/not found. Description of beacon: ..... Height Top of Vanes to Top Mark ..... m. Height of mark ..... m. above rock/conc ..... m. below G.L. Diameter of Vanes ..... m. Height of Cairn ..... m. Original Beacon has/has not been destroyed by ms.	Date ..... Record of Station .....