

CENTRAL MAPPING AUTHORITY

Department of Lands

Trigonometrical Survey of N.S.W.

RECONNAISSANCE and MAINTENANCE REPORT

This Trig. Station has been:-

Note: Cross out word or words which do not apply

1. Completely cleared to permit 360° vision to surrounding Trigs.
2. Cleared by lanes bearing..... from Trig. Mast
3. Trig. Mast & Vanes have been painted white & black respectively.
4. The Trig. was ~~unpiled~~/not unpiled, dimensions now being: Station Mast, Lanes, Vanes & Beacons

Description of mark..... should be explicit, e.g. Steel plug, Brass plug, Bolt, G.I. Pipe

Height of mark..... m above rock/concrete m below G.L.

Height of Top Vanes to Top Mark..... m. Diameter of Vanes (vertical)..... m.

Height of Cairn..... m. Diameter of Cairn..... m.

Length of Mast..... m. (approximate if not unpiled)

5. A..... set in conc/rock has been placed..... m. bearing.....°M from Trig. Mast
6. A..... set in conc/soil has been placed..... m. bearing.....°M from Trig. Mast
7. A..... set in conc/soil has been placed..... m. bearing.....°M from Trig. Mast
8. A..... set in conc/rock has been placed..... m. bearing.....°M from Trig. Mast

9. Connection..... to..... m. bearing.....°M

10. Connection..... to..... m. bearing.....°M

11. Connection..... to..... m. bearing.....°M

12. Connection..... to..... m. bearing.....°M

13. Diff. Ht. is..... m. above below

14. Diff. Ht. is..... m. above below

15. Diff. Ht. is..... m. above below

16. Diff. Ht. is..... m. above below

Prepared by: Johnnie 21/4/77 Checked: _____

Noted on U.T.M. Card

Checked

STATION YULLUNDY T.S. 5220

Co: GORDON | Ph: BURGOON



Map Sheet: CUMNOCK 150 000 | No: 8632-S

Inspected by: J. SHERWIN | Date: 22/3/77

Authority: C.M.A. | Field Book:

Beacon Diagram

Not to Scale

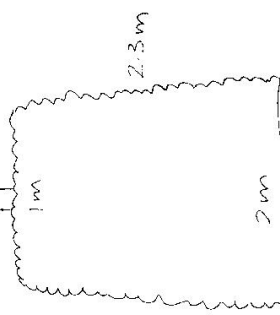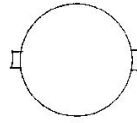


Date

Record of Station

Address


Access

Via "Macclesfield" (See Cumrock 150,000 8632-S)
Drive to After $\frac{1}{2}$ Days light work shifting loose rubble.
Excellent all round vision (Candolox T.S.)
Suitable Pillar.

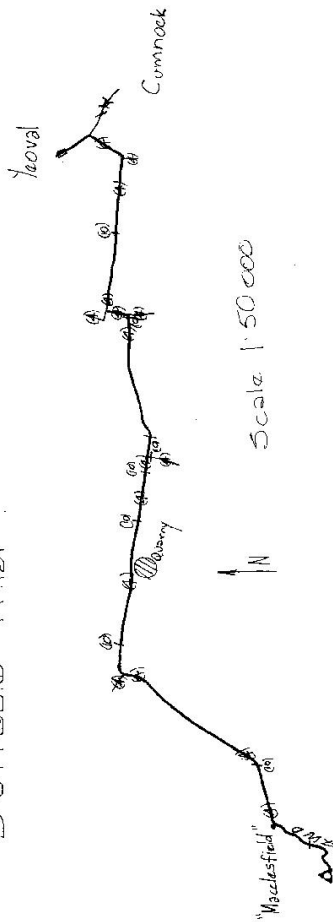

Yullondry T.S.

Scale 1.50000

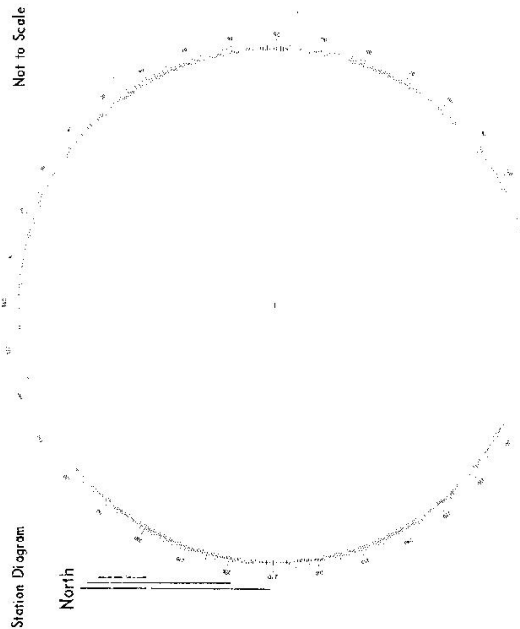

List of Observed Directions: -

[illegible]