

GEODETIC SURVEY OF N.S.W.

CENTRAL MAPPING AUTHORITY


GEODETIC STATION RECONNAISSANCE and MAINTENANCE REPORT

STATION: **ST. GEORGE** No.: **TS 5225**

MAP SHEET SCALE 1:250 000 **CANBERRA**

INSPECTED BY: **H.C. BORDER** DATE: **30-11-78**

AUTHORITY: **C.M.A** FIELD BOOK: **01411**

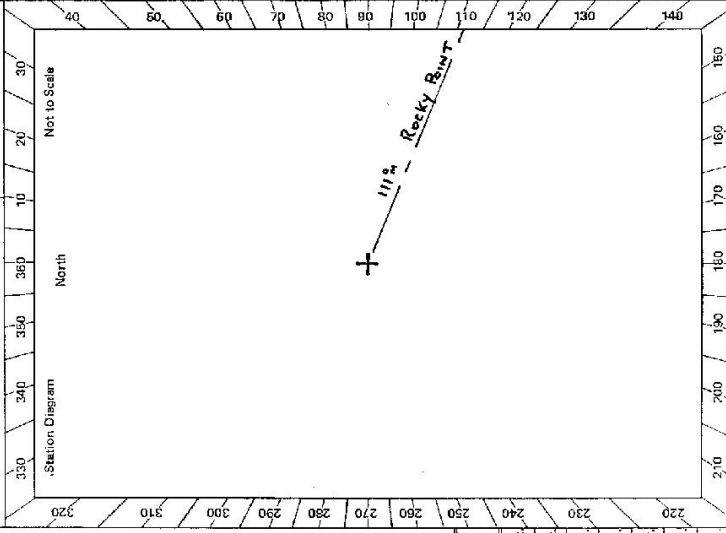

Description:
 Note: Cross out word or words which do not apply
 1. Cleared by lanes bearing **Timber** ~~Timber~~ **part line 119°** from Trig. Mast
 2. Mast & Vanes have been painted white & black respectively.
 3. The station ~~marker~~ was ~~unfilled~~ ~~not unpiled~~ ~~observed on~~ **19** m, dimensions now being:
 Description of mark.....should be explicit, e.g., S/Steel Pillar Plate, Steel plug, Brass plug, Bolt, G.I. Pipe
 Height of mark.....m. above rock/concrete; Mark is.....m. above G.L.
 Height of Top Vanes to Top ~~Marker~~ **Cairn** ~~Marker~~ **2.20** m. Diameter of Vanes (vertical) **0.950** m.
 Height of Cairn.....m. Diameter of Cairn.....m. Name Plate ~~found~~ ~~not found~~ ~~placed~~
 Length of Mast **3.90** m. (approximate if not unplied)
 4. ~~No. marks found~~ **1** set in conc/rock has been placed/found, bearing.....° M from Mast/Plug/Pillar
 5. A.....set in conc/rock has been placed/found, bearing.....° M from Mast/Plug/Pillar
 6. A.....set in conc/rock has been placed/found, bearing.....° M from Mast/Plug/Pillar
 7. A.....set in conc/rock has been placed/found, bearing.....° M from Mast/Plug/Pillar
 8. Action required: **about 2 days clearing with chain saws for lanes, new mast & vanes required.**

STANDPOINT:

Mark	Direction	Hor. Distance	Height Difference	Mark	Direction	Horiz. Distance	Height Difference
			above standpt.				above standpt.
			below				below
			above standpt.				above standpt.
			below				below
Prepared by: **H.C. BORDER** Checked: **Noted on U.T.M. Card**

Sr 2733-2 D. West, Government Printer

STATION **St. George** **IS 5225**

Owner's Name: **Not Known** Current Occupant:
 Address: Address:
 Phone: Phone:

ACCESS

Access Report of **20/11/1978** was found suitable/unsuitable.
 from Collector Post Office corner, travel northward along **km's**
 Federal Highway, crossing collector bridge at: **0.50**
 turning SW, crossing turn off on R.H.S. at: **1.50**
 past rest area + Geary's Gap T.S. at: **15.00**
 turn off Federal Highway, onto track + gate "CORRY" R.H.S. at: **22.80**

"CORRY" on gate drive northward along track
 through gate + past track on L.H.S. at: **0.00 km's**
 across field at: **0.60**
 past track on R.H.S. to house. at: **1.00**
 through gate at: **2.00**
 past track on L.H.S. at: **3.00**
 through gate at: **3.10**
 past track on L.H.S. at: **4.00**
 past orange conc. P.M.G post at: **4.80**
 past track on L.H.S. at: **5.10**
 through gate (Sheep yard) at: **5.50**
 track to ting on L.H.S. at: **5.70**
 ting at: **6.30**
 track to ting on L.H.S. at: **7.10**
 ting at: **7.20**

Track to Road 400 with Red + white Mast over G.I. pipe in conc. (cont. Survey marker 36),
 in a better site for a conc. Pillar, just north of ting, slightly lower than Ting site.
 see field book 01411.

Beacon Diagram Not to Scale

This section to be completed by officer constructing pillar.

Original station mark ~~found~~/not found.

Description of mark: **not unimpaled!**

Original beacon found/~~not~~found. **Rock Cairn Mast + Vanes (poor)**

Description of beacon: **Cairn 2.20**

Height Top of Vanes to Top ~~Mark~~.....m.

Height of mark.....m. above rock/conc.....m. above G.L. below

Diameter of Vanes **0.950**.....m. Height of Cairn **1.70**.....m.

Original Beacon ~~was~~/has not been destroyed by me.

Date	Record of Station