

STATION BERNL 5 5229

Current Occupant.....


Address.....

Owners Name.....

Address.....

Access 22-5-75
 GULGONG P.O. 6.00 km
 Take DUNEDOO ROAD
 TURN LEFT 4.8 km
 TURN LEFT INTO GATE abt 7km
 JUST PAST SUB-STATION
 TS CAN BE SEEN FROM ROAD.

Station Diagram Not to Scale

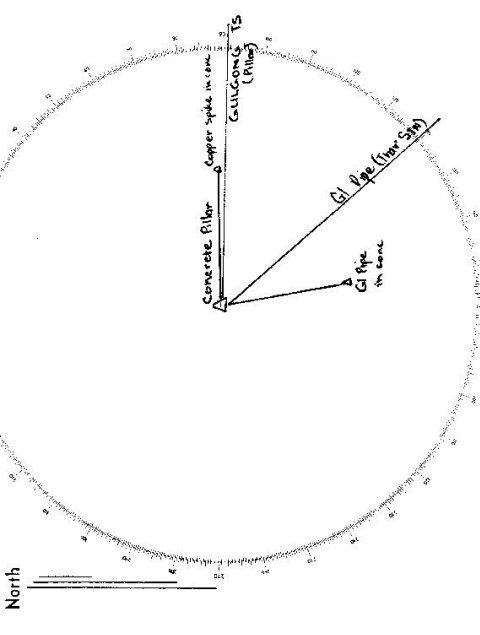

List of Observed Directions:-

Standpoint: Concrete Pillar		Standpoint:	
Station	Direction	Station	Direction
GULGONG TS (Pillar)	0° 54' 00"		
Cl Pipe (near sign)	43° 21' 34"		
Cl Pipe in cone	133° 46' 43"		
COPPER SPIKE IN CONE	358° 52' 21"		
Station	Direction	Station	Direction

CENTRAL MAPPING AUTHORITY

GEODETTIC SURVEY OF N.S.W.

GEODETTIC STATION RECONNAISSANCE and MAINTENANCE REPORT

Description:

- Note: Cross out word or words which do not apply
1. Cleared by lances bearing 162° to 162° , 162° to 162° , 162° to 162° from Trig. Mast
Guccoon 5 480 895m
 2. Mast & Vanes have been painted white & black respectively.
 3. The station/pillar was unpiled/~~re-constructed~~/re-constructed on 19^{th} August 1981, dimensions now being:
St lance base should be explicit, e.g., S/Steel Pillar Plate, Steel plug, Brass plug, Bolt, G.I. Pipe
 - Description of mark 1405 m. above ~~rock~~ concrete; Mark is 1505 m. above G.L.
 - Height of Top Vanes to Top ~~Mast~~/Pillar plate 1455 m. Diameter of Vanes (vertical) 0.905 m.
 - Height of Cairn 1455 m. Diameter of Cairn 1455 m. Name Plate found/~~not found~~/placed.
 - Length of Mast 1405 m. (approximate if not unpiled)
 4. A. 1405 set in conc/rock has been placed/found, bearing 162° M from Mast/Plug/Pillar
 5. A. 1405 set in conc/rock has been placed/found, bearing 162° M from Mast/Plug/Pillar
 6. A. 1405 set in conc/rock has been placed/found, bearing 162° M from Mast/Plug/Pillar
 7. A. 1405 set in conc/rock has been placed/found, bearing 162° M from Mast/Plug/Pillar
 8. Action required: 1405

STANDPOINT:

Mark	Direction	Horiz. Distance	Height Difference	Mark	Direction	Horiz. Distance	Height Difference
			above standpt				above standpt
			below				below
			above standpt				above standpt
			below				below
Prepared by: P. Batts 20th August Checked: *[Signature]*

S-2733-1

Noted on U.T.M. Card

STATION: *Beryl G.S.(1)* No: *5229*

MAP SHEET SCALE 1:250 000 *Dubbo*

INSPECTED BY: *P. Batts* DATE: *19.8.81*

AUTHORITY: *C.M.A* FIELD BOOK: *1725*

Station Diagram

Not to Scale

Sr 2733-2 D. West, Government Printer	STATION <u>Beryl E.S (P) 5229</u>	Owner's Name: <u>MA T. J. HONEYSETT</u> Address: <u>160 ROYL STREET</u> <u>COLSONE</u> Phone: <u>74-4425</u> Current Occupant: Address: Phone: ACCESS Access Report of 19.1.8.19. It was found suitable/unsuitable. LEAPFROG BOY OFFICE BUILDING TAKE DUNEDOO ROAD 5.15 TURN LEFT SIGN BERYL just after sub-station 7.57 TURN LEFT THROUGH DOUBLE ROW GATES MAKE WAY TO KIG 7.06 BERYL G.S.(2)
Beacon Diagram Not to Scale 		Record of Station Date
This section to be completed by officer constructing pillar. Original station mark found/not found. Description of mark: Original beacon found/not found. Description of beacon: Height Top of Vanes to Top Markm. Height of markm. above G.L. below Diameter of Vanesm. Height of Cairnm. Original Beacon has/has not been destroyed by me.		