

CENTRAL MAPPING AUTHORITY

GEODETIC SURVEY OF M.S.W.

GEODETIC STATION RECONNAISSANCE and MAINTENANCE REPORT


STATION: **PINE RIDGE** No.: **5237**

MAP SHEET SCALE 1:250 000 **CANBERRA (A.C.T)**

INSPECTED BY: **D.K. BARNALL** DATE: **June 78**

AUTHORITY: FIELD BOOK:

- Description:
- Note: Cross out word or words which do not apply*
1. Cleared by lanes bearing..... from Trig. Mast
 2. ~~Mast & Vanes have been painted white & black-respectively.~~ *Steel guardpost with names.*
 3. The station/pillar was unpiled/not unpiled/constructed on..... 19....., dimensions now being: Description of mark.....should be explicit, e.g., S/Steel Pillar Plate, Steel plug, Brass plug, Bolt, G.I. Pipe Height of mark.....m. ^{above} rock/concrete; Mark is.....m. ^{above} G.L.
 4. A.....set in conc/rock has been placed/found, bearing.....° M from Mast/Plug/Pillar
 5. A.....set in conc/rock has been placed/found, bearing.....° M from Mast/Plug/Pillar
 6. A.....set in conc/rock has been placed/found, bearing.....° M from Mast/Plug/Pillar
 7. A.....set in conc/rock has been placed/found, bearing.....° M from Mast/Plug/Pillar
 8. Action required: *No. action required*

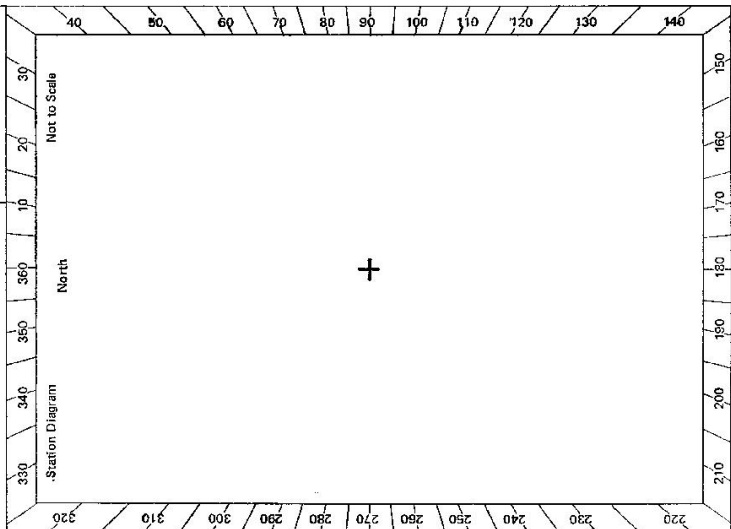

STANDPOINT:				STANDPOINT:			
Mark	Direction	Horiz. Distance	Height Difference	Mark	Direction	Horiz. Distance	Height Difference
			above standpt.				above standpt.
			below				below
			above standpt.				above standpt.
			below				below
Prepared by:

Checked:

Noted on U.T.M. Card

