

CENTRAL MAPPING AUTHORITY

Department of Lands

Trigonometrical Survey of N.S.W.

RECONNAISSANCE and MAINTENANCE REPORT

This Trig. Station has been:-

Note: Cross out word or words which do not apply

- 1. ~~Completely cleared to permit 360° vision to surrounding Trig.~~
- 2. Cleared by lanes bearing *56477 E 90° 23' 28" S* from Trig. Mast
- 3. Trig. Mast & Vanes have been painted white & black respectively. ✓
- 4. The Trig. was unpiled/ ~~not unpiled~~, dimensions now being: *Concrete base 4.5m x 4.5m x 0.6m* ^{Vertical Staffing} ~~Concrete base 4.5m x 4.5m x 0.6m~~ should be explicit, e.g. Steel plug, Brass plug, Bolt, G.I. Pipe

Description of mark: *Concrete base 4.5m x 4.5m x 0.6m*

Height of mark: *Black* m above rock/concrete *White* m above G.L. below

Height of Top Vanes to Top *Black* m *White* m Diameter of Vanes (vertical) *2.00 m*

Height of *Black* m *White* m Diameter of Cairn *1.00 m*

Length of Mast *6.50 m* (approximate if not unpiled)

- 5. A *Trig. Mast* set in *conc/rock* has been placed *15.30 m* bearing *34° 0' M* from Trig. Mast *Black*
- 6. A *Concrete* set in *conc/earth* has been placed *12.78 m* bearing *161° 0' M* from Trig. Mast *Black*
- 7. A *Concrete* set in *conc/earth* has been placed *17.09 m* bearing *78° 0' M* from Trig. Mast *Black*
- 8. A *Trig. Mast* set in *conc/rock* has been placed *6° 0' M* from Trig. Mast *Black*

- 9. Connection *Concrete* to *Trig. Mast* *17.30 m* bearing *6° 0' M* *Trig. Mark A Cross in Rock Pt.*
- 10. Connection *Concrete* to *Trig. Mast* *12.52 m* bearing *333° 0' M*
- 11. Connection *Concrete* to *Concrete* *16.61 m* bearing *31° 0' M*

- 12. Connection to *Trig. Mast* *17.30 m* bearing *6° 0' M*
- 13. Diff. Ht. *15.30 m* above *Trig. Mast* below
- 14. Diff. Ht. *15.30 m* above *Trig. Mast* below
- 15. Diff. Ht. *15.30 m* above *Trig. Mast* below
- 16. Diff. Ht. *15.30 m* above *Trig. Mast* below

Prepared by: *M.I. Moore* Checked: *M.I. Moore*

Noted on U.T.M. Card *M.I. Moore*

Checked


STATION *ROSSCOLE Crs. Point TS 5251*

Co: *BRISBANE* Ph: *ELLIS*

Map Sheet: *MUSWELLBROOK* No: *9033 N*

Inspected by: *L. R. HOLLIS* Date: *AUGUST 1972*

Authority: _____ Field Book: _____

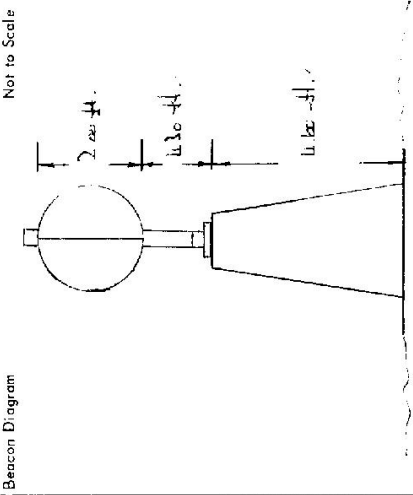

Date	Record of Station

Department of Lands
 STATION T3 POSSIBLE FALLAC (5251)

Integrating SURVEY OF N.S.W.
 RECONNAISSANCE AND MAINTENANCE REPORT

Co: Brisbane
 Ph: Brogheada
 Map Sheet: Muswellbrook
 No: 9033
 Inspected by: G. VELSHAM
 Date: 22.11.17
 Authority: ISD NOLE
 Field Book: 95B

This Trig. Station has been: cleared by Jones-bearing from Trig. Mast

1. Completely cleared to permit 360° vision to surrounding Trigs. ✓
2. Cleared by Jones-bearing ✓
3. Trig. Mast & Vanes have been painted white & black respectively. ✓
4. The Trig. was unpiled/removed, dimensions now being:

Description of mark: concrete pillar should be explicit, e.g. Steel plug, Brass plug, Bolt, Concrete Pillar

Height of mark: 1.3 m. rock, concrete 1.3 m above G.L.

Height of Top Vanes to Top Mark/Top pillar plate: 1.45 m Diameter of Vanes (vertical): 0.60 m.

Height of Cairn: 1.3 m. Diameter of Cairn: m.

Length of Mast: 1.54 m. (approximate if not unpiled)

5. A Copper Spike set in conc./rock has been placed/d 3.692 m. bearing 159°M from Trig. Mast/pillar

6. A X in Rock set in conc./soil has been placed/d 4.454 m. bearing 273°M from Trig. Mast/pillar

7. A G.I. Pipe set in conc./soil has been placed/d 3.900 m. bearing 75°M from Trig. Mast/pillar

8. A set in conc./rock has been placed/d m. bearing °M from Trig. Mast/pillar

9. Connection G.I.P. to C.S. 5.068 m. bearing 209°M

10. Connection G.I.P. to X in Rock 3.813 m. bearing 330°M

11. Connection to m. bearing °M

12. Connection to m. bearing °M


13. Diff. Ht. Pillar Plate is 1.320 m. above C.S.

14. Diff. Ht. Pillar Plate is 1.335 m. above G.I.P.

15. Diff. Ht. Pillar Plate is 1.356 m. above X on Rock

16. Diff. Ht. is m. above

Prepared by: Checked:

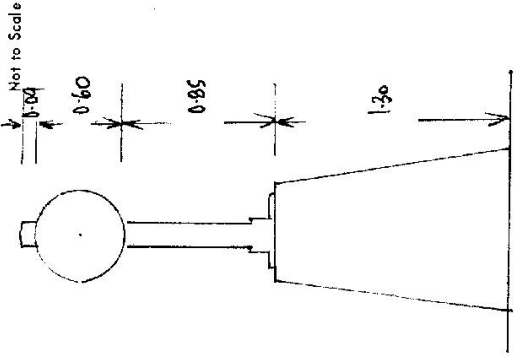

Date	Record of Station
22/11/17	New Mast & Vanes placed.

CENTRAL MAPPING AUTHORITY

GEODETIC STATION RECONNAISSANCE and MAINTENANCE REPORT

STATION: **ROSSCOLE (P)** No.: **TS 5251**

MAP SHEET SCALE 1:250 000 **SINGLETON**

INSPECTED BY: **A. GARSDIE** DATE: **14/11/78**

AUTHORITY: **C. M. A.** FIELD BOOK:

Description: *Note: Cross out word or words which do not apply*

1. Cleared by lanes bearing..... from Trig. Mast
2. Mast & Vanes have been painted white & black respectively.
3. The station/pillar was unpiled/not unpiled/constructed on.....19....., dimensions now being: Description of mark. **S/S P. Plate** should be explicit, e.g., S/Steel Pillar Plate, Steel plug, Brass plug, Bolt, G.I. Pipe Height of mark.....m. ^{above} rock/concrete; Mark is **L. 3.7**.....m. ^{above} G.L.
4. A..... **Cross**.....set in ~~conc~~/~~rock~~ has been ~~placed~~/~~found~~, bearing.....**34**.....° M from Mast/Plug/Pillar
5. A..... **G.I. Pipe**.....set in conc/rock has been placed/found, bearing.....**78**.....° M from Mast/Plug/Pillar
6. A..... **Copper Nail**.....set in conc/rock has been placed/found, bearing.....**61**.....° M from Mast/Plug/Pillar
7. A.....set in conc/rock has been placed/found, bearing.....° M from Mast/Plug/Pillar
8. Action required:.....

Height of Top Vanes to Top Mark/Pillar plate **L. 4.50**.....m. Diameter of Vanes (vertical) **0.62**.....m.

Height of Cairn.....m. Diameter of Cairn.....m. Name Plate found/~~not found~~/~~placed~~:

Length of Mast.....m. (approximate if not unpiled)

STANDPOINT:


STANDPOINT:

Mark	Direction	Horiz. Distance	Height Difference	Mark	Direction	Horiz. Distance	Height Difference
			above standpt.				above standpt.
			below				below
			above standpt.				above standpt.
			below				below
Prepared by: **A. Garisdie 14/11/78** Checked:

Noted on U.T.M. Card

St 2733--1

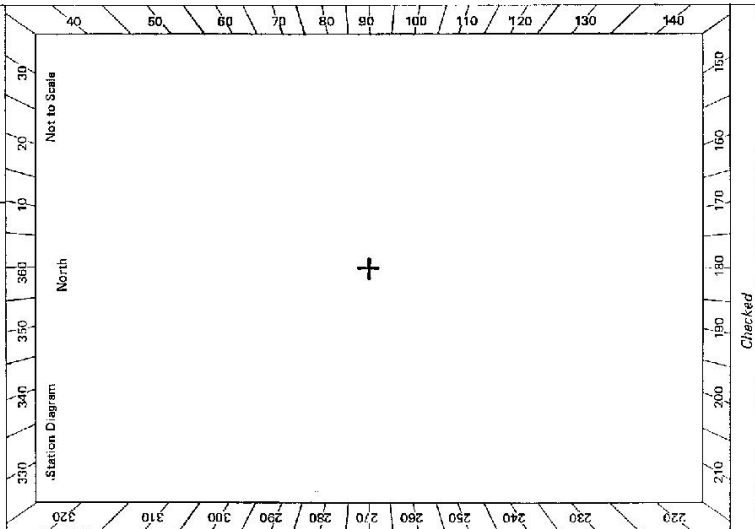

Checked

GS 24

STATION ROSSCOLE C/P TS 5251	Owner's Name: Address: Phone: Current Occupant: Address: Phone: Access Report of: <u>100/197.2</u> was found suitable/ <u>was suitable</u> . ACCESS
Beacon Diagram 	This section to be completed by officer constructing pillar. Original station mark found/not found. Description of mark: Original beacon found/not found. Description of beacon: Height Top of Vanes to Top Mark:m. Height of merk:m. above rock/conem. below G.L. Diameter of Vanes:m. Height of Cairn:m. Original Beacon has/has not been destroyed by me.
Date 14/11/23	Record of Station Pillar, mark, and vanes, painted..... Original..... X in rock... found..... disturbed.....

STATION TS 5251 ROSSCOLE PILLAR

Owners Name: Rosscole Rock Co

Current Occupant:

Address of Rosscole:

Address:

Via Hardleem

Access 22-11-1977

km 12.4

0-0 Hardleem - travel north along New England Hwy toward scene.
 2-4 Turn left onto Dartbrook Road.
 5-9 Turn right at Road Junction - sign 'ROSSCOLE' Dirt Road through grid.

6-1 Grid.

16-7 Grid

18-0 Grid

19-7 Grid

20-5 Grid

21-5 Gate

21-8 Gate - Entrance to Rosscole Homestead.

22-5 Gate - Homestead on LHS - Follow track between fences.

22-6 Gate - keep fence on LHS.

23-6 Gate - follow faint track up ridge to left.

25-6 Gate

27-9 TELC.

Access by conventional vehicle in dry. Inoperable in wet.

