

GEODETIC SURVEY OF N.S.W.

CENTRAL MAPPING AUTHORITY

GEODETIC STATION RECONNAISSANCE and MAINTENANCE REPORT

Description:

Note: Cross out word or words which do not apply

1. Cleared by-lanes-bearing..... from Trig, Mast
2. Mast & Vanes have been painted white & black respectively, in case of rocks found
3. The station/pillar was unspiked/not unspiked/constructed on..... 49....., dimensions now-being-
Description of mark..... should be explicit, e.g., S/Steel Pillar Plate, Steel plug, Brass plug, Bolt, G.I. Pipe
Height of mark.....m. above rock/concrete; Mark is.....m. above G.L.
Height of Top Vanes to Top Mark/Pillar platem. Diameter of Vanes (vertical).....m.
Height of Cairn.....m. Diameter of Cairn.....m. Name Plate found/not found/placed.
Length of Mast.....m. (approximate if not unspiked)
4. A.....set in conc./rock has been placed/found, bearing.....° M from Mast/Plug/Pillar
5. A.....set in conc./rock has been placed/found, bearing.....° M from Mast/Plug/Pillar
6. A.....set in conc./rock has been placed/found, bearing.....° M from Mast/Plug/Pillar
7. A.....set in conc./rock has been placed/found, bearing.....° M from Mast/Plug/Pillar
8. Action required: *Station drive to Idays clearing required.*

STANDPOINT:

STANDPOINT:

Mark	Direction	Horiz. Distance	Height Difference	Mark	Direction	Horiz. Distance	Height Difference
			above standpt.				above standpt.
			below				below
			above standpt.				above standpt.
			below				below
Prepared by: *P.K. Bamola 14/6/79* Checked:

Noted on U.T.M. Card

SI 2753-1

STATION: *Round Hill* No.: *5252*

MAP SHEET SCALE 1:250 000 *CAMBERRA*

INSPECTED BY: *P.K. Bamola* DATE: *June 79*

AUTHORITY: *CMA* FIELD BOOK:

GEODETTIC SURVEY OF N.S.W.

CENTRAL MAPPING AUTHORITY

GEODETTIC STATION RECONNAISSANCE and MAINTENANCE REPORT

STATION: ROUND HILL	T'S No.: 5252
MAP SHEET SCALE 1:250 000 CANBERRA	
INSPECTED BY: G. KEEP	DATE: 8/7/80
AUTHORITY: C.M.A.	
FIELD BOOK:	

- Description:**
 1. Cleared by lanes bearing.....
Note: Cross out word or words which do not apply
 2. ~~Mast & Vanes have been painted white & black respectively~~..... from Trig. Mast
 3. The station/pillar was unpiled/hot unpiled/constructed on..... 19....., dimensions now being:
 Description of mark..... should be explicit, e.g., S/Steel Pillar Plate, Steel plug, Brass plug, Bolt, G.I. Pipe
 Height of mark.....^{above} rock/concrete; Mark is.....^{above}.....^{below}..... G.L.
 Height of Top Vanes to Top Mark/Pillar plate.....m. Diameter of Vanes (vertical).....m.
 Height of Cairn.....m. Diameter of Cairn.....m. Name Plate found/not found/placed.
 Length of Mast.....3.85.....m. (approximate if not unpiled)
 4. A.....set in conc/rock has been placed/found, bearing.....° M from Mast/Plug/Pillar
 5. A.....set in conc/rock has been placed/found, bearing.....° M from Mast/Plug/Pillar
 6. A.....set in conc/rock has been placed/found, bearing.....° M from Mast/Plug/Pillar
 7. A.....set in conc/rock has been placed/found, bearing.....° M from Mast/Plug/Pillar
 8. Action required: No. marks found, needs painting black and white and a sign set out.

STANDPOINT:			
Mark	Direction	Horiz. Distance	Height Difference
			above standpt
			below standpt
			above standpt
			below standpt
Prepared by: *G. Keep 20/7/80* Checked: *C. M. A.* Noted on U.T.M. Card *C. M. A.*




STATION ROUND HILL TS 5252

Owner's Name:
 Address:
 Phone:
 Current Occupant:
 Address:
 Phone:

ACCESS

Access Report of 8.7.1980 was found suitable/unsuitable.
 From Cooma P.O. travel north on Monaro Highway towards Canberra. Go to locked gate on left hand side of road 890 m N of C40 (Cooma 40km) or 510 m north of concrete bridge over Gungahdra Creek (SP). After gate follow 132kv power line North and turn left at dam (before ruin) up a track to top of ridge. Follow top of ridge south to trig station.

Note: Key for locked gate can be obtained from Electricity Commission in Cooma.

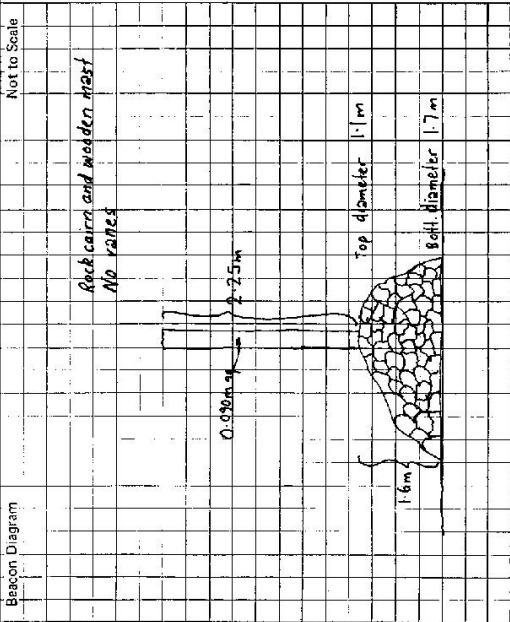

This section to be completed by officer constructing pillar.

Original station mark found/not found.

Description of mark:

Original beacon found/not found.

Description of beacon:

Height Top of Vane to Top Mark.....m.

Height of mark.....m. above G.L.
 below

Diameter of Vane.....m. Height of Cairn.....m.

Original Beacon has/not been destroyed by me.

Date	Record of Station