

GEODETIC SURVEY OF N.S.W.

CENTRAL MAPPING AUTHORITY

GEODETIC STATION RECONNAISSANCE and MAINTENANCE REPORT

Description:

1. Cleared by lanes bearing..... *Not checked*..... Note: *Cross out word or words which do not apply*
2. Mast & Vanes have been painted white & black respectively.
3. The station/~~pillar~~ was ~~unpiled~~/not unpiled/constructed on..... *l.l. 19.7.?*..... dimensions now being:
 Description of mark..... should be explicit, e.g., S/Steel Pillar Plate, Steel plug, Brass plug, Bolt, G.I. Pipe
 Height of mark.....^{above} m.....^{below} m..... rock/concrete; Mark is.....^{above} m.....^{below} G.L.
 Height of Top Vanes to Top Mark/Pillar plate..... m..... Diameter of Vanes (vertical)..... m.
 Height of Cairn..... m..... Diameter of Cairn..... m..... Name Plate found/not found/placed.
 Length of Mast..... m..... (approximate if not unpiled)
4. A..... set in conc/rock has been placed/found; bearing.....[°]M from Mast/Plug/Pillar
5. A..... set in conc/rock has been placed/found; bearing.....[°]M from Mast/Plug/Pillar
6. A..... set in conc/rock has been placed/found; bearing.....[°]M from Mast/Plug/Pillar
7. A..... set in conc/rock has been placed/found; bearing.....[°]M from Mast/Plug/Pillar
8. Action required:.....

STANDPOINT:

Mark	Direction	Horiz. Distance	Height Difference	Mark	Direction	Horiz. Distance	Height Difference
			above standpt				above standpt
			below standpt				below standpt
			above standpt				above standpt
			below standpt				below standpt
Prepared by: *W. Miller*

Checked: *W. Miller*

SS 2743-1

Noted on U.T.M. Card

STATION: BURRA GS No.: 5264
 MAP SHEET SCALE 1:250 000 CANBERRA
 INSPECTED BY: W MILLER DATE: 11.1.79
 AUTHORITY: CMA FIELD BOOK:

Station Diagram
 North
 Not to Scale

STATION **BURRA GS 5264**



Current Occupant:
 Address:
 Phone:

Owner's Name:
 Address:
 Phone:

ACCESS

Access Report of 11.1.72. It was found suitable/unsuitable.

At "Rock Forest"
 Go past the shearing shed through gate and follow track.
 At the second gate past the shearing shed (not counting the gate at the shed) turn right up fence line and pass through gate. Go past dam and turn right up hill. Follow this low ridge for approx 1km and pass through small steel gate. Make way up ridge. towards trig.
 Possible to drive in dry conditions.

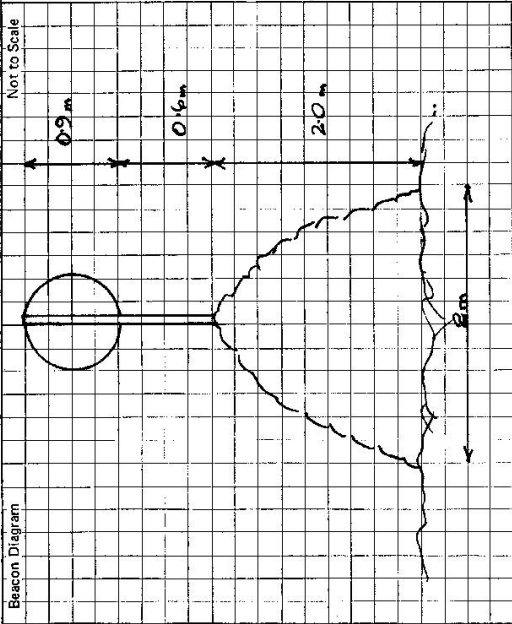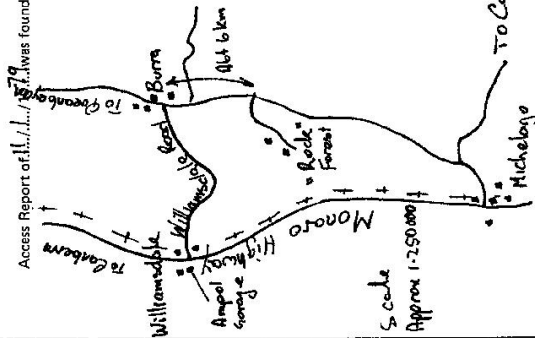

This section to be completed by officer constructing pillar.

Original station mark found/not found.

Description of mark:

Original beacon found/not found.

Description of beacon:

Height Top of Vanes to Top Mark:m.

Height of mark:m. above rock/cont.m. below G.L.

Diameter of Vanes:m.

Height of Cairn:m.

Original Beacon has/has not been destroyed by me.

Record of Station

Date

11.1.72 Visited *advised*