


STATION BELFORD TS. 5267

Owners Name.....
 Current Occupant.....
 Address.....
 Address.....

Access Nov 1975
 90kms. From SINGLETON P.O. TAKE ROAD TO MATTLAND.
 12.0kms Turn onto old highway to right.
 Follow track to powerline and TS.

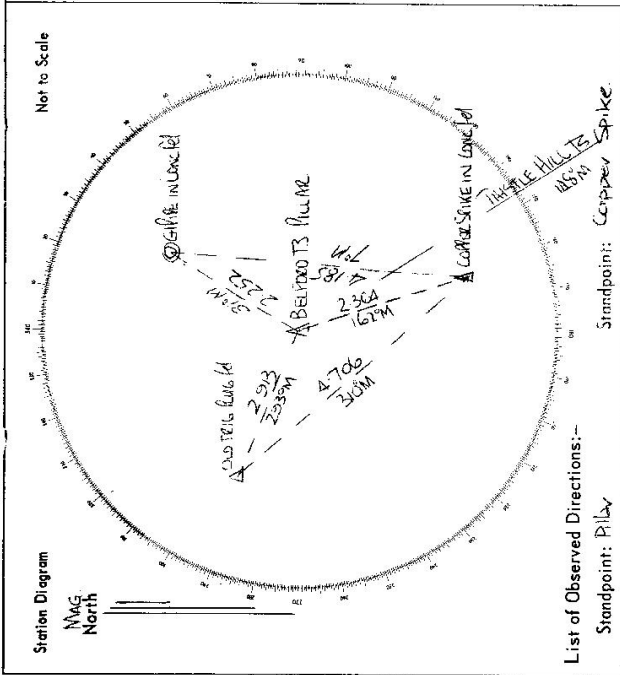

List of Observed Directions:-

Station	Direction	Station	Direction
MUSTIE HILL TS	359 87.60	THISTLE HILL TS	351 87.60
CORRIVE SPIKE IN LONG HILL	140 18.12	BELFORD TS - Pillar	194 18.39
BELFORD TS (TWO PILLARS)	145 15.51	CORRIVE IN LONG HILL	278 42.49
CORRIVE IN LONG HILL	244 21.32	OLD TELE PILLAR	164 13.54

Standpoint: Copper Spike

GEODETIC SURVEY OF N.S.W.

CENTRAL MAPPING AUTHORITY

GEODETIC STATION RECONNAISSANCE and MAINTENANCE REPORT


STATION: BELFORD (Pillar) G.S. No.: 5267

MAP SHEET SCALE 1:250 000 Station Name: Sibleton

INSPECTED BY: D. J. Kain DATE: 11 April 1979

AUTHORITY: C.M.A. FIELD BOOK: 1673.

- Description:
- Cleared by lanes bearing... *Clearance by lanes... from Trig. Mast Pillar.*
 - Mast & Vanes have been painted white & black respectively. *Note: Cross out word or words which do not apply. Inspected, Mast & Vanes were replaced.*
 - The station/pillar was... *Station/pillar was replaced on 19.11.1979, dimensions now being: 3/4" Steel Cap is now fitted to pillar plate.*
- Description of mark: *5/8" Pipe. This should be explicit, e.g., S/Steel Pillar Plate, Steel plug, Brass plug, Bolt, G.I. Pipe*
- Height of mark... *3.68 m. above rock/concrete; Mark is 1.11 m. above G.L.*
- Height of Top Vanes to Top Mast/Pillar plate... *1.939 m. Diameter of Vanes (vertical) 0.600 m.*
- Height of Cairn... *0 m. Diameter of Cairn... m. Name Plate found/act... ⁵ C.M.A. Geodetic Station Belford T.S.*
- Length of Mast... *2.929 m. (approximate)*
- A... *5/8" Pipe* set in conc/rock has been placed/found, bearing... *160° M from Mast/Pillar 1972.*
 - A... *G.I. Pipe* set in conc/rock has been placed/found, bearing... *32° M from Mast/Pillar*
 - A... set in conc/rock has been placed/found, bearing... *0° M from Mast/Plug/Pillar*
 - A... set in conc/rock has been placed/found, bearing... *0° M from Mast/Plug/Pillar*
- Action required:

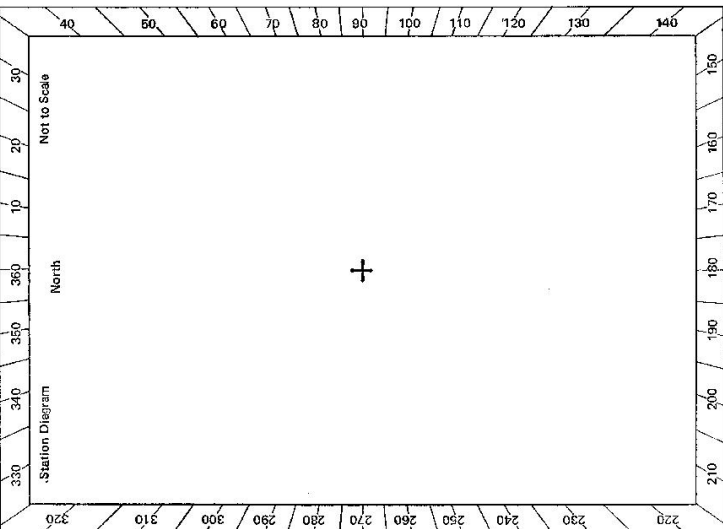

STANDPOINT:				
Mark	Direction	Horiz. Distance	Height Difference	Prepared by:
			above standpt.	Checked: <i>[Signature]</i> Noted on U.T.M. Card
			below standpt.	
			above standpt.	
			below standpt.	
			above standpt.	
			below standpt.	
			above standpt.	
			below standpt.	

Prepared by: *[Signature]* Checked: *[Signature]*


8x 2738-2 D. West, Government Printer

STATION Belfield (Rise) G.S. 5267

Owner's Name:
 Address:
 Phone:
 Current Occupant:
 Address:
 Phone:

ACCESS
 Access Report of 7/4/1979 was found suitable/unsuitable.

Note:- Access as per previous,
 Key to Locked gate on access to this station available
 from, 55 House Street, ✓
 Singleton.

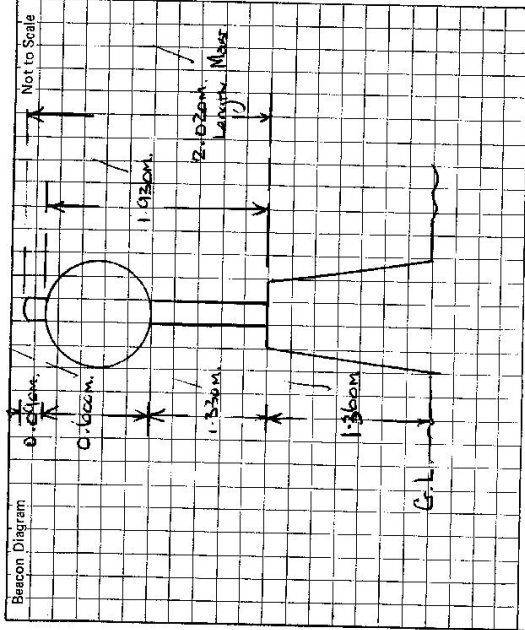

This section to be completed by officer constructing pillar.

Original station mark found/not found.
 Description of mark:
 Original beacon found/not found.
 Description of beacon:
 Height Top of Vanes to Top Mark m.
 Height of mark m. above G.L. below rock/conc m.
 Diameter of Vanes m. Height of Cairn m.
 Original Beacon has/has not been destroyed by me.

Date	Record of Station

CENTRAL MAPPING AUTHORITY

GEODETTIC SURVEY OF N.S.W.


GEODETTIC STATION RECONNAISSANCE and MAINTENANCE REPORT

STATION: BELFORD GSOP No.: 5267

MAP SHEET SCALE 1:250 000 SINGLETON

INSPECTED BY: I ROBINSON DATE: 17-7-79

AUTHORITY: C.M.A. ANGLE BOOK: 1585/23

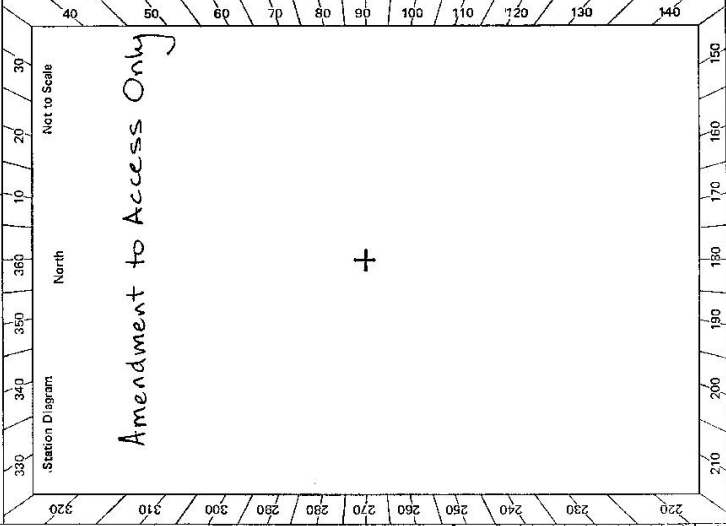

- Description:
- Note: Cross out word or words which do not apply
1. Cleared by Janes bearing..... from Trig, Mast
 2. Mast & Vanes have been painted white & black respectively.
 3. The station/pillar was unpiled/not unpiled/constructed on.....19....., dimensions now being: Description of mark.....should be explicit, e.g., S/Steel Pillar Plate, Steel plug, Brass plug, Bolt, G.I. Pipe
Height of mark.....m. ^{above}/_{below} rock/concrete; Mark is.....m. ^{above}/_{below} G.L.
 - Height of Top Vanes to Top Mark/Pillar platem. Diameter of Vanes (vertical).....m.
 - Height of Cairn.....m. Diameter of Cairn.....m. Name Plate found/not found/placed.
 - Length of Mastm. (approximate if not unpiled)
 4. A.....set in conc/rock has been placed/found, bearing.....°M from Mast/Plug/Pillar
 5. A.....set in conc/rock has been placed/found, bearing.....°M from Mast/Plug/Pillar
 6. A.....set in conc/rock has been placed/found, bearing.....°M from Mast/Plug/Pillar
 7. A.....set in conc/rock has been placed/found, bearing.....°M from Mast/Plug/Pillar
 8. Action required:.....

STANDPOINT:			
Mark	Direction	Horiz. Distance	Height Difference
			above standpt.
			below standpt.
			above standpt.
			below standpt.
Prepared by: I.W. Robins, 14/7/79 Checked: G. Paden 31/7/79 Noted on U.T.M. Card

