

CENTRAL MAPPING AUTHORITY


GEODETIC SURVEY OF N.S.W.

GEODETIC STATION RECONNAISSANCE and MAINTENANCE REPORT

Description:

1. Cleared by lances bearing 205° to 320° m. *Note: Cross out word or words which do not apply*
 2. Mast & Vanes have been painted white & black respectively. ✓
 3. The station/pillar was unpainted/repainted/conserved on *29th September 1981*, dimensions now being:
 Description of mark *to Rice Trig* should be explicit, e.g., S/Steel Pillar Plate; Steel plug, Brass plug, Bolt, G.I. Pipe
 Height of mark 1.976 m. ^{above} ~~below~~ *rock/concrete*; Mark is 1.405 m. ^{above} ~~below~~ G.L.
 Height of Top Vanes to Top Mast/Pillar plate 1.460 m. Diameter of Vanes (vertical) 0.780 m.
 Height of Cairn..... m. Diameter of Cairn..... m. Name Plate found/~~not found~~/placed.
 Length of Mast..... m. (approximate if not unpled)
 4. A. *Rice Trig* set in conc/~~rock~~ has been ~~replaced~~/found, bearing 293° M from ~~Mast/Pillar~~/Pillar
 5. A. *S.S.M* set in conc/~~rock~~ has been ~~placed~~/found, bearing 291° M from ~~Mast/Pillar~~/Pillar
 6. A..... set in conc/~~rock~~ has been placed/found, bearing..... M from Mast/Plug/Pillar
 7. A..... set in conc/~~rock~~ has been placed/found, bearing..... M from Mast/Plug/Pillar
 8. Action required:.....

STATION: *Cable G.S. (N)* No: *5270*
 MAP SHEET SCALE 1:250 000 *D. 11610*
 INSPECTED BY: *Peters* DATE: *21-9-81*
 AUTHORITY: *C.M.A.* FIELD BOOK: *20925*

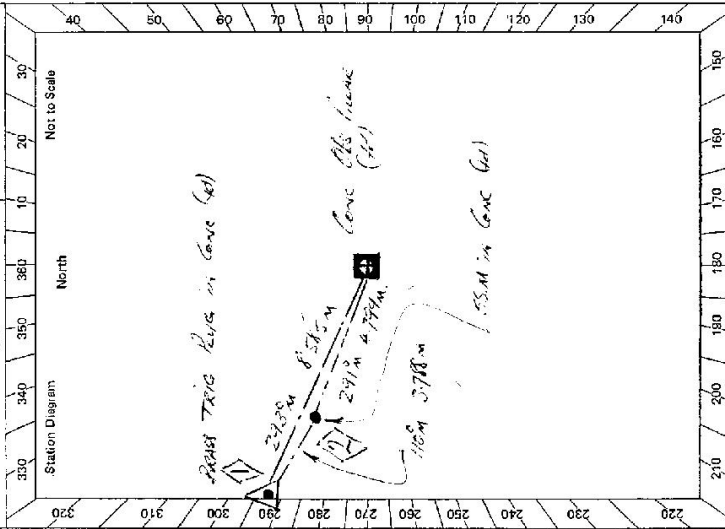

STANDPOINT:				STANDPOINT:			
Mark	Direction	Horiz. Distance	Height Difference	Mark	Direction	Horiz. Distance	Height Difference
			above standpt.				above standpt.
			below				below
			above standpt.				above standpt.
			below				below
Prepared by: *Peters* 29th September 81. Checked: *Peters*
 Noted on U.T.M. Card

GS 24

<p>ST 2733 2 D. West, Government Printer</p> <p>Beacon Diagram</p> <p style="text-align: right;">Not to Scale</p>	<p style="text-align: center;">STATION <u>Dubbo, C.C.</u> TS <u>5270</u></p> <p>Owner's Name: Address: Phone:</p> <p>Current Occupant: Address: Phone:</p> <p style="text-align: center;">ACCESS</p> <p>Access Report of 21/9/19 <u>was found suitable/unsuitable.</u> FEATING K.M. POST OFFICE DUBBO HEAD NEST ON MARGUERITE STREET TURN RIGHT ONTO MURCHELL HIGHWAY TOWARDS ARROWBINE 340 TURN LEFT OFF HIGHWAY THEN TURN SHARP LEFT TOWARDS MITEE TANK 344 TURN RIGHT ACCESS END 351 ROAD GATE DATA LOCK LISTED 362 DUBBO GS (2)</p>
<p>This section to be completed by officer constructing pillar.</p> <p>Original station mark found/not found.</p> <p>Description of mark:</p> <p>Original beacon found/not found.</p> <p>Description of beacon:</p> <p>Height Top of Vanes to Top Mark. m. above below Height of mark. m. above G.L. below Diameter of Vanes. m. Height of Cairn. m. Original Beacon has/h as not been destroyed by me.</p>	
<p>Date</p> <p>Record of Station</p>	

STATION TS 5270 DUBBO [P]


Current Occupant.....

Address.....

Owners Name.....


Address.....

Station Diagram

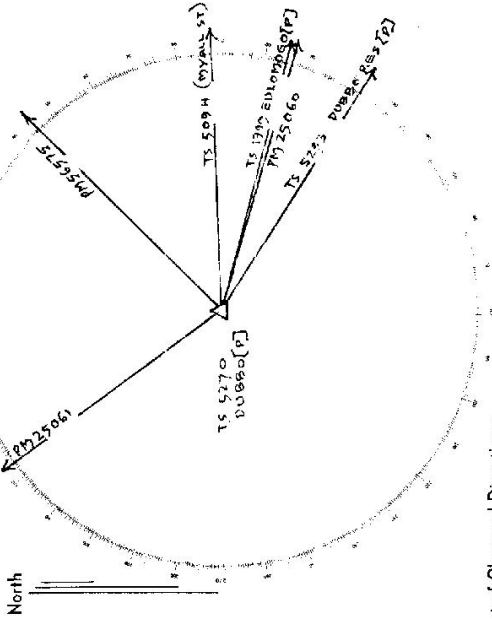

List of Observed Directions:-

Station	Direction	Station	Direction
TS 1999 EUMOMO60 [P]	105° 00' 00"	TS 1999 EUMOMO60 [P]	105° 00' 00"
TS 5273 DUBBO RESS [P]	122° 51' 33.4"	200 RADIO MAST	100° 11' 20.3"
PM 25061	324° 42' 11.3"	TS 5232 DUBBO RESS [P]	111° 51' 34.4"
PM 56575	35° 00' 45.1"		
TS 5094 MYALL ST [P]	88° 20' 59.1"		
PM 25060	105° 38' 07.3"		

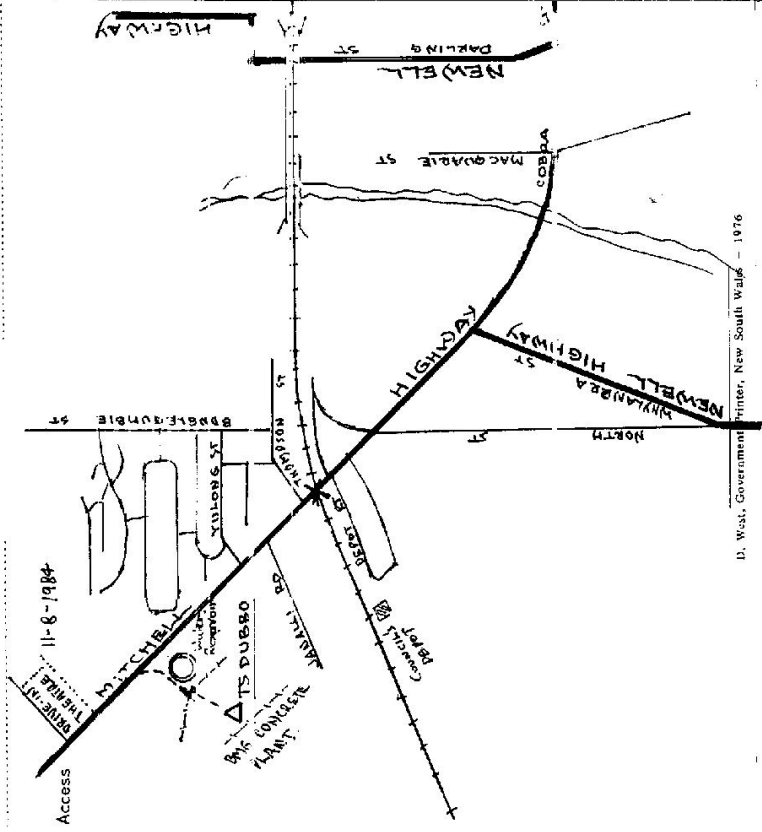


STATION TS 5270 DUBBO [P]

Owners Name.....
 Current Occupant.....


Address.....
 Address.....

Access 11-8-1984

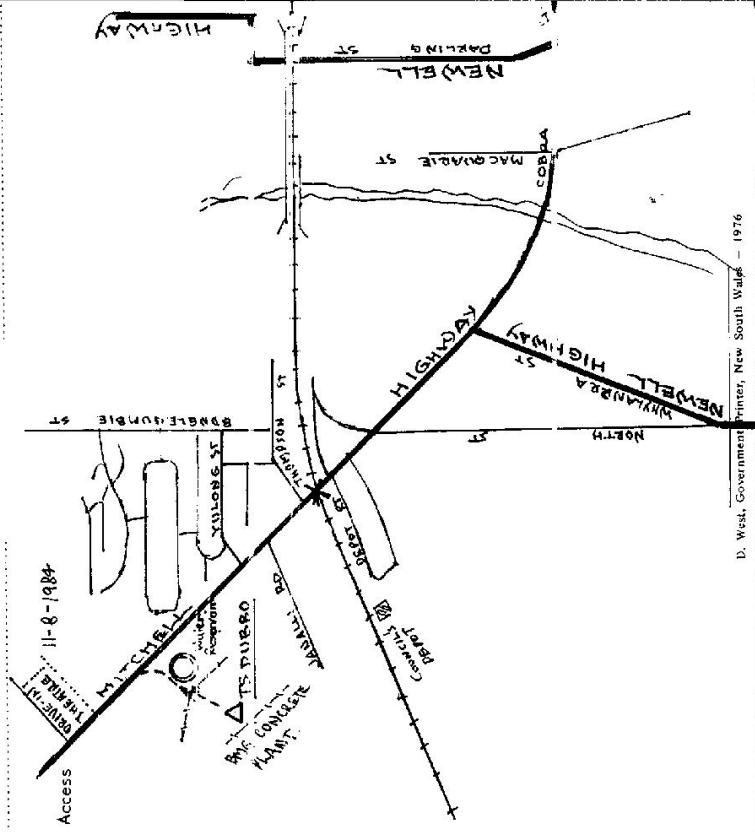

D. West, Government Printer, New South Wales - 1976

Station Diagram Not to Scale

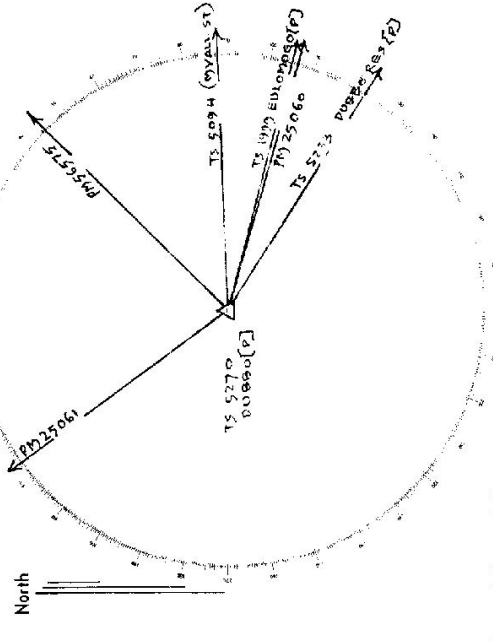

List of Observed Directions:-

Station	Direction	Station	Direction
TS 1999 EUMOMO [P]	105° 00' 00"	TS 1999 EUMOMO [P]	105° 00' 00"
TS 5270 DUBBO [P]	122° 51' 33.4"	TS 5270 DUBBO [P]	104° 11' 12.3"
PM 25061	324° 42' 11.3"	TS 5252 DUBBO RES [P]	111 51 314
PM 56577	45° 00' 45.1"		
TS 5094 NYAAL ST [P]	88° 20' 59.1"		
PM 75060	105° 38' 07.3"		

Station	Direction	Station	Direction
TS 5270 DUBBO [P]		TS 5270 DUBBO [P]	

Station	Direction	Station	Direction