

CENTRAL MAPPING AUTHORITY
Department of Lands

Trigonometrical Survey of N.S.W.

RECONNAISSANCE and MAINTENANCE REPORT

This Trig. Station has been:-

Note: Cross out word or words which do not apply

1. Completely cleared to permit 360° vision to surrounding Trig.
2. Cleared by lanes bearing Not cleared 360° from Trig. Mast
need to be
3. Trig. Mast & Vanes ~~have been~~ painted white & black respectively.
4. The Trig. was unpiled/~~not~~unpiled, dimensions now being:

Description of mark Bronze Trig. Plug in conc. should be explicit, e.g. Steel plug, Brass plug, Bolt, G.I. Pipe
Height of mark 0.015 m above rock/concrete m above G.I. below

Height of Top Vanes to Top Mark 3.775 m. Diameter of Vanes (vertical) 0.91 m.

Height of Cairn 0.93 m. Diameter of Cairn 2. m.

- Length of Mast 3.81 m. (approximate if not unpiled)
5. A set in conc/rock has been placed m. bearing °M from Trig. Mast
 6. A set in conc/soil has been placed m. bearing °M from Trig. Mast
 7. A set in conc/soil has been placed m. bearing °M from Trig. Mast
 8. A set in conc/rock has been placed m. bearing °M from Trig. Mast

9. Connection to m. bearing °M
10. Connection to m. bearing °M
11. Connection to m. bearing °M
12. Connection to m. bearing °M
13. Diff. Ht. m. above below
14. Diff. Ht. m. above below
15. Diff. Ht. m. above below
16. Diff. Ht. m. above below

NO WITNESSES MARKS FOUND

Prepared by: J.R.77 Checked:

Noted on U.T.M. Card

STATION **EVANS** TS **5272**


Co: **Buller** Ph: **Evans**

Map Sheet: **BONALBO** No: **9440**

Inspected by: **A. Sivertsen** Date: **22-11-77**

Authority: **CMA** Field Book: **1613**

Beacon Diagram 0.02 Not to Scale

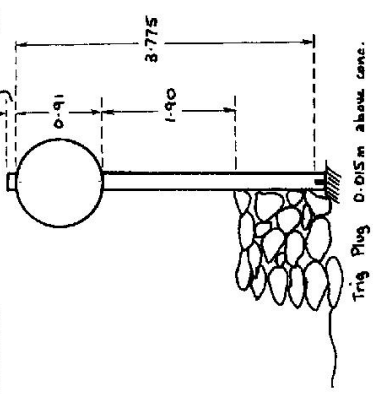

NOTE: Plug found loose in conc. but could be re-generated without disturbing. Rooftop pillar could be placed.

Date	Record of Station
	2-3 days clearing Owner's permission granted

Checked

