

GEODETTIC SURVEY OF NSW

CENTRAL MAPPING AUTHORITY

GEODETTIC STATION RECONNAISSANCE and MAINTENANCE REPORT

Description:

1. Cleared by lanes bearing. *Note: Cross out word or words which do not apply*

2. Mast & Vanes have been painted white & black respectively.

3. The station/pillar was unpiled/not unpiled/constructed on.....19..... dimensions now being:

Description of mark.....should be explicit, e.g, S/Steel Pillar Plate, Steel plug, Brass plug, Bolt, G.I. Pipe

Height of mark.....m. ^{above} rock/concrete; Mark is.....m. ^{above} G.L.

Height of Top Vanes to Top Mark/Pillar platem. Diameter of Vanes (vertical).....m.

Height of Cairn.....m. Diameter of Cairn.....m. Name Plate found/not found/placed.

Length of Mast.....m. (approximate if not unpiled)

4. A.....set in conc/rock has been placed/found, bearing.....°M from Mast/Plug/Pillar

5. A.....set in conc/rock has been placed/found, bearing.....°M from Mast/Plug/Pillar

6. A.....set in conc/rock has been placed/found, bearing.....°M from Mast/Plug/Pillar

7. A.....set in conc/rock has been placed/found, bearing.....°M from Mast/Plug/Pillar

8. Action required:.....

STANDPOINT:


Mark	Direction	Horiz. Distance	Height Difference	Mark	Direction	Horiz. Distance	Height Difference
			above standpt.				above standpt.
			below standpt.				below standpt.
			above standpt.				above standpt.
			below standpt.				below standpt.
Prepared by: C. Hanna

Checked: Noted on U.T.M. Card

ST 2733-1

STATION: BELMORE No.: 5282
 MAP SHEET SCALE 1:250 000 NARROMINE
 INSPECTED BY: G. C. HANNA DATE: 2/10/78
 AUTHORITY: C.M.A. FIELD BOOK:

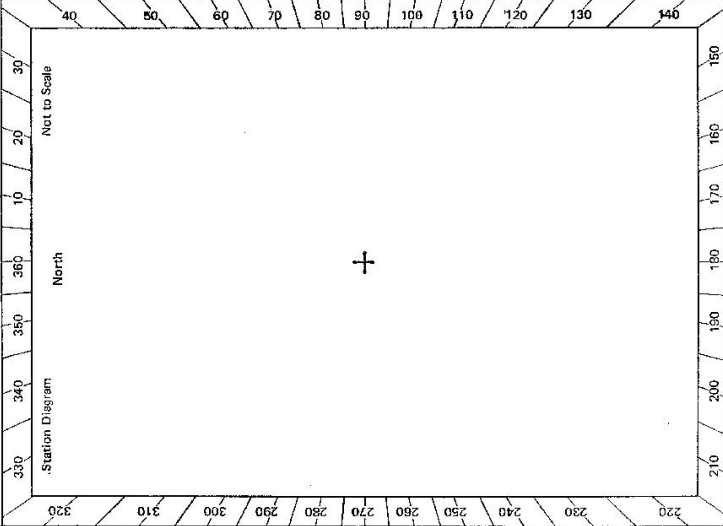

Checked

St 2733-2 D. West, Government Printer Beacon Diagram	STATION BELMORE * 5282	Owner's Name: Address: Phone: Current Occupant: Address: Phone: ACCESS Access Report of 2/10/19. It was found suitable/unsuitable. Trig on highest point of hill Cairn 1.2m Mast & vanes found destroyed Heavy clearing required ACCESS 0-0 Shell garage Tomingley towards Dubbo 3-9 R.H. turn towards Obley 13-2 Road on left. Go straight ahead 28-25 R.H. turn towards Belmore 28-95 Stop on L.H. side of Road. Trig on left 5 minute walk.
Not to Scale		This section to be completed by officer constructing pillar. Original station marks found/not found. Description of mark: Original beacon found/not found. Description of beacon: Height Top of Vanes to Top Mark.....m. Height of mark.....m. above below rock/conc.....m. above below G.L. Diameter of Vanesm. Height of Cairnm. Original Beacon has/has not been destroyed by me.
		All measurements are approximate
		Date Record of Station