
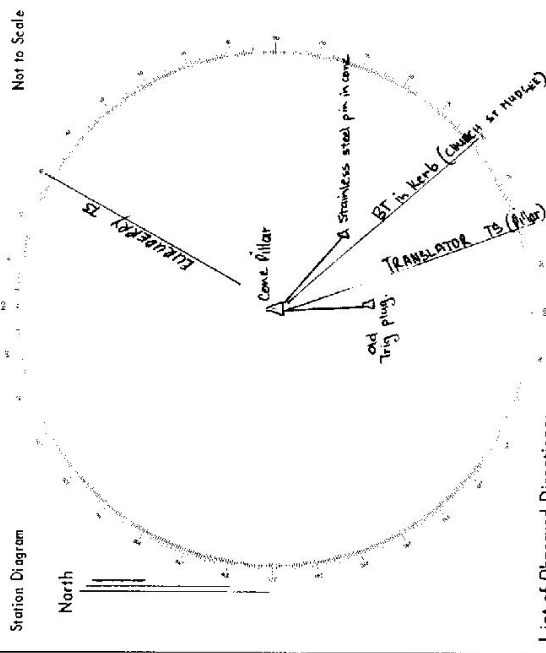


STATION MUDGEE TS (P) 5321

Owners Name:
 Current Occupant:
 Address:
 Address:

Access 20/5/15
 FROM MUDGEE TAKE ROAD TO
 GULGONG.
 CROSS OVER RAILWAY LINE 0.0 km.
 TURN RIGHT INTO ROAD 2.4 km. TRIG CAN BE
 SIGNPOSTED 'ABBATOIRS' SEEN FROM ROAD.
 TAKE FIRST GATE ON 3.6 km.
 RIGHT (ALMOST AT TURNOFF).

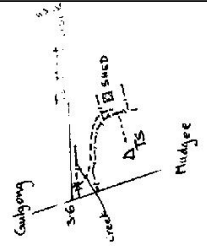

List of Observed Directions:-

Standpoint: CONE PILLAR		Standpoint:	
Station	Direction	Station	Direction
TRANSLATOR TS (Alter)	0° 00' 00"		
old trig plug	12° 08' 30"		
stainless steel pin	232° 30' 58.2"		
BT in Kerb	310° 18' 30"		
	334° 35' 14.8"		
Station	Direction	Station	Direction

CENTRAL MAPPING AUTHORITY

Trigonometrical Survey of N.S.W.

Department of Lands

RECONNAISSANCE and MAINTENANCE REPORT

This Trig. Station has been:-

Note: Cross out word or words which do not apply

1. Completely cleared to permit 360° vision to surrounding Trigs.
2. Cleared by lanes bearing from Trig. Mast
3. Trig. Mast & Vanes have been painted white & black respectively.
4. The Trig. was unpiled/not unpiled, dimensions now being: Station $\frac{m}{m}$

Description of mark..... should be explicit, e.g. Steel plug, Brass plug, Bolt, G.I. Pipe

Height of mark..... m above rock/concrete m below G.L.

Height of Top Vanes to Top Mark..... m. Diameter of Vanes (vertical)..... m.

Height of Cairn..... m. Diameter of Cairn..... m.

Length of Mast..... m. (approximate if not unpiled)

5. A..... set in conc/rock has been placed..... m. bearing.....°M from Trig. Mast
6. A..... set in conc/soil has been placed..... m. bearing.....°M from Trig. Mast
7. A..... set in conc/soil has been placed..... m. bearing.....°M from Trig. Mast
8. A..... set in conc/rock has been placed..... m. bearing.....°M from Trig. Mast

9. Connection..... to..... m. bearing.....°M

10. Connection..... to..... m. bearing.....°M

11. Connection..... to..... m. bearing.....°M

12. Connection..... to..... m. bearing.....°M

13. Diff. Ht. is..... m. above below

14. Diff. Ht. is..... m. above below

15. Diff. Ht. is..... m. above below

16. Diff. Ht. is..... m. above below

Prepared by: N. MORTON

Checked: Noted on U.T.M. Card

STATION MUDGEE TS 5321


Co: WELLINGTON Ph: MURINA

Map Sheet: MUDGEE No: 832 1dIV

Inspected by: N MORTON Date: MAY 1977

Authority: M.A. Field Book:

Beacon Diagram Not to Scale

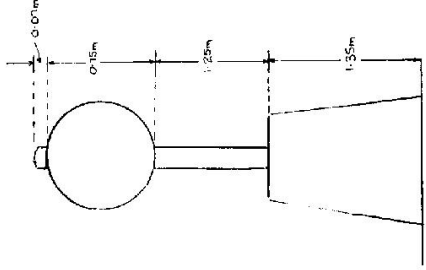

Date

Record of Station

GEODETTIC SURVEY OF N.S.W.

CENTRAL MAPPING AUTHORITY

GEODETTIC STATION RECONNAISSANCE and MAINTENANCE REPORT

STATION: **MUDGE (P)** No.: **5321**

MAP SHEET SCALE 1:250 000

DUBBO


INSPECTED BY: **D. KINLYSIDE** DATE: **23.5.78**

AUTHORITY: **CMA**

FIELD BOOK: **—**

Description: *Note: Cross out word or words which do not apply*

1. Cleared by lanes bearing..... from Trig. Mast
2. Mast & Vanes have been painted white & black respectively.
3. The station/pillar was unpiled/not unpiled/constructed on..... 19....., dimensions now being: Description of mark..... should be explicit, e.g., S/Steel Pillar Plate, Steel plug, Brass plug, Bolt, G.I. Pipe
- Height of mark.....m. above rock/concrete; Mark is.....m. above below G.L.
- Height of Top Vanes to Top Mark/Pillar plate.....m. Diameter of Vanes (vertical).....m.
- Height of Cairn.....m. Diameter of Cairn.....m. Name Plate found/not found/placed.
- Length of Mast.....m. (approximate if not unpiled)
4. A..... set in conc/rock has been placed/found, bearing.....° M from Mast/Plug/Pillar
5. A..... set in conc/rock has been placed/found, bearing.....° M from Mast/Plug/Pillar
6. A..... set in conc/rock has been placed/found, bearing.....° M from Mast/Plug/Pillar
7. A..... set in conc/rock has been placed/found, bearing.....° M from Mast/Plug/Pillar
8. Action required:.....

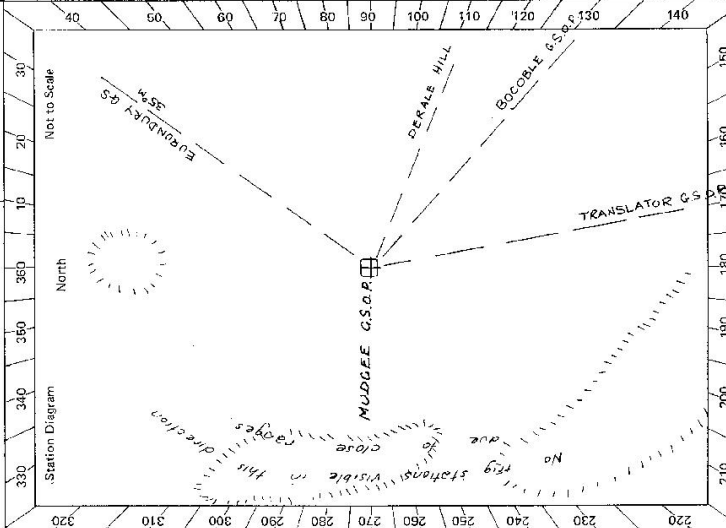

STANDPOINT:		STANDPOINT:		STANDPOINT:		STANDPOINT:	
Mark	Direction	Horiz. Distance	Height Difference	Mark	Direction	Horiz. Distance	Height Difference
			above standpt.				above standpt.
			below				below
			above standpt.				above standpt.
			below				below
Prepared by: *Shyjaal* 20-5-78. Checked: *W. Palmer* 22/7/78. Noted on U.T.M. Card

Checked

G

STATION **MUDGEES GISC** TS **5321**

Owner's Name: **Mr. J. De Koning**
 Address: **Sourley**
 Phone:

Current Occupant: **MR. M. DEAN T.S.O. (son)**
 Address: **"M. DEAN"**
 Phone: **(082) 72 64 77**

ACCESS

Access Report of 15/12/1981 was found suitable/unsuitable.

KM FEATURE
0.00 BEST OFFICE MUDGEES HEAD TOMASS BUSHONG
3.22 CROSS RAIL LINE
3.36 TRAIL ROAD INTO "MINAH" PROPERTY & CROSS BRID
4.22 TRAIL LEAD THROUGH FENCE 20 METRES OFF RAIL BRID
4.70 TRAIL LEAD & MAKE OWN WAY AROUND TOP OF TREES
4.94 GEODETIC STATION MUDGEES

Not to Scale

Beacon Diagram

This section to be completed by officer constructing pillar.

Original station mark found/not found.

Description of mark:

Original beacon found/not found.

Description of beacon:

Height Top of Vanes to Top Markm.

Height of markm. above G.L. below

Diameter of Vanesm. Height of Catinm.

Original Beacon has/has not been destroyed by me.

Date	Record of Station