

GEODETTIC SURVEY OF N.S.W.

CENTRAL MAPPING AUTHORITY


GEODETTIC STATION RECONNAISSANCE and MAINTENANCE REPORT

STATION: **MYALL GS** No.: **5325**

MAP SHEET SCALE 1:250 000 **CANBERRA**

INSPECTED BY: **N. MILLER** DATE: **1-2-79**

AUTHORITY: **CMA** FIELD BOOK:

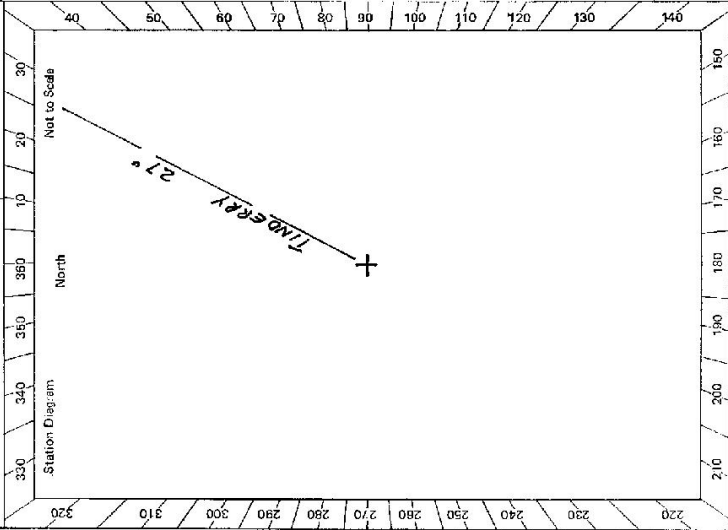

- Description:
1. Cleared by lances bearing **360°** **vision** *Note: Cross out word or words which do not apply* **1-2-79** from Trig, Mast
2. Mast & Vanes have been painted white & black respectively.
3. The station/~~pillar~~ was ~~unplaced~~/~~not unplaced~~/~~relocated~~ on **1-2-79** **1978**, dimensions now being:
 Description of mark.....should be explicit, e.g., S/Steel Pillar Plate, Steel plug, Brass plug, Bolt, G.I. Pipe
 Height of mark.....m. ^{above} rock/concrete; Mark is.....m. ^{above} G.L.
 Height of Top Vanes to Top Mark/Pillar plate.....m. Diameter of Vanes (vertical).....m.
 Height of Cairn.....**1.5**m. Diameter of Cairn.....**2**m. Name Plate found/not found/placed.
 Length of Mast.....**3.5**m. (approximate if not unplaced)
4. A.....**set** in conc/rock has been placed/round, bearing.....° M from Mast/Plug/Pillar
5. A.....**set** in conc/rock has been placed/round, bearing.....° M from Mast/Plug/Pillar
6. A.....**set** in conc/rock has been placed/round, bearing.....° M from Mast/Plug/Pillar
7. A.....**set** in conc/rock has been placed/round, bearing.....° M from Mast/Plug/Pillar
8. Action required.....

STANDPOINT:				
Mark	Direction	Horiz. Distance	Height Difference	Mark
			above standpt.	
			below standpt.	
			above standpt.	
			below standpt.	
Prepared by: **N. Miller** 26-2-79 Checked: **Checked**

GS 24

<p>STATION MYALL GS TS 5325</p>	<p>Owner's Name: Address: Phone:</p> <p>Current Occupant: Address: Phone:</p> <p>ACCESS</p> <p>Access Report of 1.2.1979 was found suitable/unsuitable</p> <p>Myall, J</p> <p>Walk from here</p> <p>Make your own track up hill</p> <p>Drive across dam wall.</p> <p>Ingelara Creek</p> <p>Ingelara</p> <p>Monro Bredbo 15km</p> <p style="text-align: right;">Scale 1:25000</p>
<p>Beacon Diagram</p> <p>Not to Scale</p>	<p>This section to be completed by officer constructing pillar.</p> <p>Original station mark found/not found.</p> <p>Description of mark:</p> <p>Original beacon found/not found.</p> <p>Description of beacon:</p> <p>Height Top of Vanes to Top Markm. above G.L. below G.L.</p> <p>Height of markm. above G.L. below G.L.</p> <p>Diameter of Vanesm. Height of Cairnm.</p> <p>Original Beacon has/has not been destroyed by me.</p>
<p>Date</p> <p>12-19</p>	
<p>Record of Station</p> <p>12-19</p>	