


Department of Lands Integral Survey of N.S.W.
RECONNAISSANCE and MAINTENANCE REPORT 5333 STATION SAVOY (P) 75 5333

This Trig. Station has been:-
 Note: Cross out word or words which do not apply

Co: **DURHAM** Ph: **WYNN**
 Map Sheet: **MUSWELLBROOK** No: **9033**
 Inspected by: **A. GRAHAM** Date: **19.7.76**
 Authority: **I.S.D. N.C.L.E** Field Book: **PPP 741**

Beacon Diagram Not to Scale

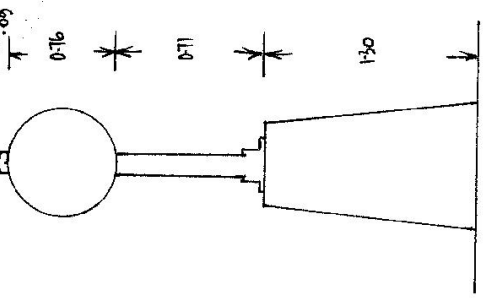

Date	Record of Station
19/7/76	Mast & vanes replaced by S.C.B., vanes 0.60 dia, effective height: 1.43

1. Completely cleared to permit 360° vision to surrounding Trigs. ✓
2. Cleared by ~~lines-bearing~~ concrete pillar from Trig. Mast
3. Trig. Mast & Vanes have been painted white & black respectively. ✓
4. The Trig. was unpiled/~~not-unpiled~~; dimensions now being:
- Description of mark: concrete pillar should be explicit, e.g. Steel plug, Brass plug, Bolt, Concrete Pillar
- Height of mark: 1.30 m ^{above} rock/concrete _{below} G.L.
- Height of Top Vanes to Top Mast/Top pillar plate: 1.47 m Diameter of Vanes (vertical): 0.76 m.
- Height of Cairn: 1.30 m. Diameter of Cairn: 33/55 m.
- Length of Mast: 1.56 m. (approximate if not unpiled)
5. A Trig Plug set in conc/~~rock~~ has been placed/fd 2.515 m, bearing 210°M from Trig. ~~Mast~~/pillar
6. A G.I.P. set in ~~conc~~/soil has been placed/fd 5.540 m, bearing 266°M from Trig. ~~Mast~~/pillar
7. A set in conc/soil has been placed/fd m, bearing °M from Trig. Mast/pillar
8. A set in conc/rock has been placed/fd m, bearing °M from Trig. Mast/pillar
9. Connection: Trig Plug to G.I.P. 3.973 m, bearing 245°M
10. Connection: to m, bearing °M
11. Connection: to m, bearing °M
12. Connection: to m, bearing °M
13. Diff. Ht. Pillar Plate is 1.487 m, ^{above} Trig. Plug
14. Diff. Ht. Pillar Plate is 1.191 m, ^{above} G.I.P.
15. Diff. Ht. is m, ^{above}
16. Diff. Ht. is m, ^{above}
- Prepared by: A. GRAHAM Checked: Allen Burrows

GEODETIC SURVEY OF N.S.W.

CENTRAL MAPPING AUTHORITY


GEODETIC STATION RECONNAISSANCE and MAINTENANCE REPORT

STATION: SAVOY (P) No.: 5333

MAP SHEET SCALE 1:250 000 MCSWELLBROOK

INSPECTED BY: DATE: 15/2/82

AUTHORITY: C.L.O. FIELD BOOK:

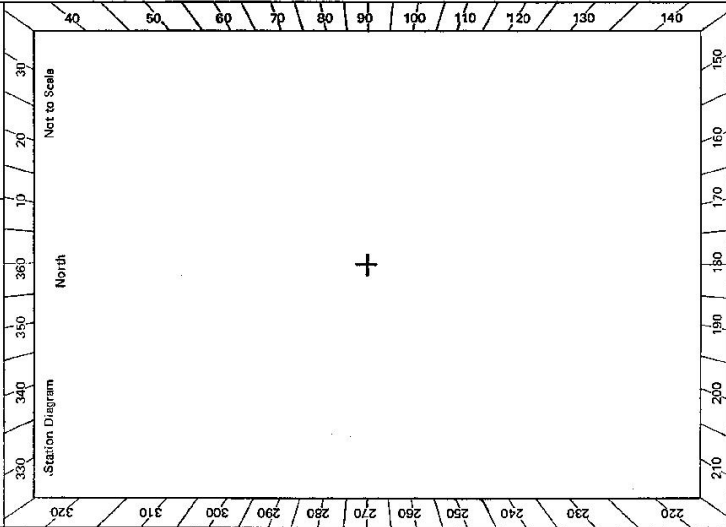

Description: Note: Cross out word or words which do not apply

1. Cleared by lanes bearing..... from Trig, Mast
2. Mast & Vanes have been painted white & black respectively.
3. The station/pillar was unpiled/not unpiled/constructed on.....19....., dimensions now being: Description of mark.....should be explicit, e.g., S/Steel Pillar Plate, Steel plug, Brass plug, Bolt, G.I. Pipe
Height of mark.....m. ^{above}/_{below} rock/concrete; Mark is.....m. ^{above}/_{below} G.L.
Height of Top Vanes to Top ~~Mark~~/Pillar plate1.4.2.....m. Diameter of Vanes (vertical).....0.50.....m.
Height of Cairn.....m. Diameter of Cairn.....m. Name Plate found/not found/placed.
Length of Mast.....m. (approximate if not unpiled)
4. A.....set in conc/rock has been placed/found, bearing.....°M from Mast/Plug/Pillar
5. A.....set in conc/rock has been placed/found, bearing.....°M from Mast/Plug/Pillar
6. A.....set in conc/rock has been placed/found, bearing.....°M from Mast/Plug/Pillar
7. A.....set in conc/rock has been placed/found, bearing.....°M from Mast/Plug/Pillar
8. Action required:.....

STANDPOINT:			
Mark	Direction	Horiz. Distance	Height Difference
			above standpt.
			below standpt.
			above standpt.
			below standpt.
Prepared by: *C. Foster* 21.9.82 Checked: *[Signature]* 22.9.82 Noted on U.T.M. Card

GS 24

STATION	SAVOY (P)	TS	5333
<p>Owner's Name:</p> <p>Address:</p> <p>Phone:</p> <p>Access Report of/...../19.....was found suitable/unsuitable.</p>	<p>Current Occupant:</p> <p>Address:</p> <p>Phone:</p> <p style="text-align: center;"><u>ACCESS</u></p>		
<p>Beacon Diagram</p>			
<p>This section to be completed by officer constructing pillar.</p> <p>Original station mark found/not found.</p> <p>Description of mark:m.</p> <p>Original beacon found/not found.</p> <p>Description of beacon:m.</p> <p>Height Top of Vanes to Top Markm.</p> <p>Height of markm. above G.L. below</p> <p>Diameter of Vanesm. Height of Cairnm.</p> <p>Original Beacon has/has not been destroyed by me.</p>			
Date		Record of Station	

STATION **SAV 5 (P) TS 5333**

Owners Name: Current Occupant:

Address: Address:

Access 19-7-1976 from Sungleton


- Feature
- 1-0. Sungleton P.O. Travel to woods Musselbrook on New England Highway
 - 32-5 Turn left at Lullwell Power Shm Entrance.
 - 34-5 Turn left at Sign "Pumping Stns"
 - 35-1 Subway under trackway.
 - 35-3 Turn Hard right.
 - 35-5 Left up gravel road beside pipeline
 - 37-2 Iron Gate. Follow track beside waterway.
 - 38-4 Iron Gate. Turn left "Atawoons" on Gate.
 - 38-6 Iron Gate. - W-18 Cut on L.H.S., follow track
 - 39-1 Grid
 - 39-7 Gate, turn Right onto bit. Road.
 - 40-0 Gate on Left - follow track beside fence
 - 40-6 Gate
 - 40-7 Turn right up ridge
 - 41-7 Pass shed on R.H.S. - follow ridge
 - 42-6 Iron Gate - pick way through rocky ridge
 - 43-3 Trig.

Access by 2 wheel drive in dry weather.

D. West, Government Printer, New South Wales - 1976

Not to Scale

Station Diagram

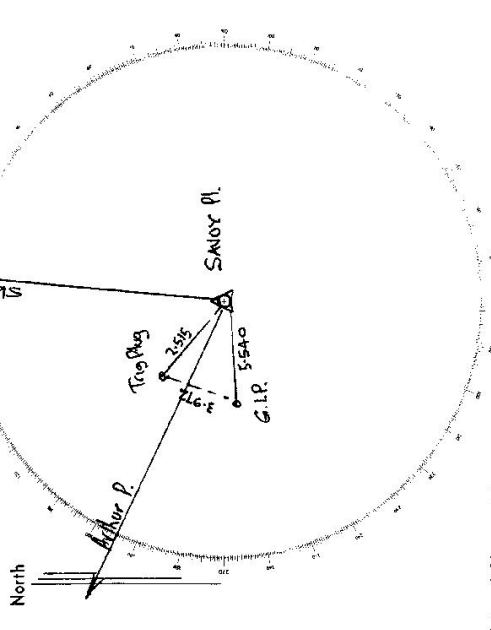

List of Observed Directions:-

Standpoint: <u>Arthur P.</u>		Standpoint: <u>Trig Plug</u>	
Station	Direction	Station	Direction
Arthur P.	0° 03' 10"	Arthur P.	0° 00' 00"
Trig Plug	91° 03' 10"	Skeleton P.	108° 30' 10"
Skeleton P.	109° 29' 21"	Arthur P.	109° 03' 15"
S.I.P.	328° 39' 42.5"	S.I.P.	304° 25' 48"
Station	Direction	Station	Direction