


7-4-88

Trigonometrical Survey of N.S.W.
 CENTRAL MAPPING AUTHORITY
 Department of Lands
 RECONNAISSANCE and MAINTENANCE REPORT

STATION SHAN VANACHAN GS 5334

Co. Durham Ph: Carrow
 Map Sheet: CAMBERWELL No: 9133
 Inspected by: N. Krahe Date: 29-11-77
 Authority: C.M.A. Field Book: 1612

Beacon Diagram Not to Scale

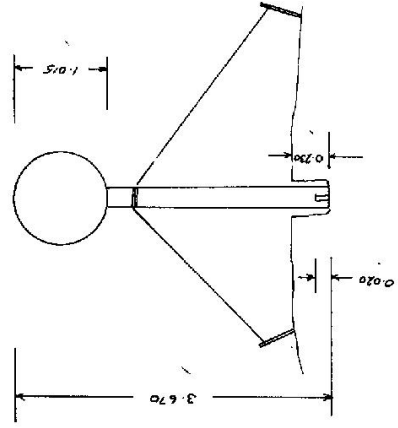

This Trig. Station has been:-
 Note: Cross out word or words which do not apply

1. Completely cleared to permit 360° vision to surrounding Trigs.
2. Cleared by ~~lanes bearing~~ from Trig. Mast
3. Trig. Mast & Vanes have been painted white & black respectively.
4. The Trig. was unpiled/~~not-unpiled~~, dimensions now being: Original Station Mast ~~not-unpiled~~
 Description of mark... set in conc/rock should be explicit, e.g. Steel plug, Brass plug, Bolt, G.I. Pipe
 Height of mark... 0.020 m ^{above}/_{below} rock/concrete G.L.
 Height of Top Vanes to Top Mark... 3.650 m. Diameter of Vanes (vertical)... 0.015 m.

Height of ~~Centr.~~ Diameter of Centr. m Mast supported by guy wires to star pickets

Length of Mast... 3.470 m. (approximate if not unpiled)

5. A. 6.4 pipe set in conc/rock has been placed to 151 m bearing 151°M from Trig. Mast
6. A. set in conc/soil has been placed to 0 m bearing 0°M from Trig. Mast
7. A. set in conc/soil has been placed to 0 m bearing 0°M from Trig. Mast
8. A. set in conc/rock has been placed to 0 m bearing 0°M from Trig. Mast
9. Connection... to... m. bearing...°M
10. Connection... to... m. bearing...°M
11. Connection... to... m. bearing...°M
12. Connection... to... m. bearing...°M
13. Diff. Ht. is is m. ^{above}/_{below}
14. Diff. Ht. is is m. ^{above}/_{below}
15. Diff. Ht. is is m. ^{above}/_{below}
16. Diff. Ht. is is m. ^{above}/_{below}

Prepared by: D. Kinsley 12.12.77 Checked: [Signature] 27/12/77

Noted on U.T.M. Card

Date	Record of Station
8-11-77	Mast Down - N. Krahe
30-11-77	New Mast and Vanes Erected - N. Krahe

Checked

