

CENTRAL MAPPING AUTHORITY

Department of Lands

Trigonometrical Survey of N.S.W.

RECONNAISSANCE and MAINTENANCE REPORT

This Trig. Station has been:-

Note: Cross out word or words which do not apply

1. ~~Completely cleared~~ to permit 360° vision to surrounding Trig.
2. Cleared by lances bearing 163° M (→ TOWNSEND TA) from Trig. Mast
ID m RADIUS ALSO CLEARED.
3. Trig. Mast & Vanes have been painted white & black respectively.
4. The Trig. ~~was emptied~~ ~~not emptied~~ dimensions now being:

Description of mark SMA PLASQUE N° 330 IN CONC should be explicit, e.g. Steel plug, Brass plug, Bolt, G.I. Pipe

Height of mark 0 ^{above} _{below} G.L.

Height of Top Vanes to Top Mark 3.62 m. Diameter of Vanes (vertical) 0.62 m.

Height of Conn. 0 m. Diameter of Conn. 0 m.

Length of Mast 3.06 m. (approximate if not unplied)

5. ~~A~~ ~~set in conc/rock~~ has been placed 0 m. bearing 0 M from Trig. Mast
6. ~~A~~ ~~set in conc/soil~~ has been placed 0 m. bearing 0 M from Trig. Mast
7. ~~A~~ ~~set in conc/soil~~ has been placed 0 m. bearing 0 M from Trig. Mast
8. ~~A~~ ~~set in conc/rock~~ has been placed 0 m. bearing 0 M from Trig. Mast

9. Connection to 0 m. bearing 0 M

10. Connection to 0 m. bearing 0 M

11. Connection to 0 m. bearing 0 M

12. Connection to 0 m. bearing 0 M

13. Diff. Ht. 0 ^{above} _{below}

14. Diff. Ht. 0 ^{above} _{below}

15. Diff. Ht. 0 ^{above} _{below}

16. Diff. Ht. 0 ^{above} _{below}

Prepared by: P. ROHNER Checked: Alan Wood 27/3/19. Noted on U.T.M. Card

5348

STATION PINNACLE (1953) SMA GS


Co: _____ Ph: _____

Map Sheet: KOSCIUSKO 1100000 No: 8525

Inspected by: ROHNER, DICKSON Date: 20-1-77

Authority: CMA Field Book: AB 1526

Beacon Diagram Not to Scale

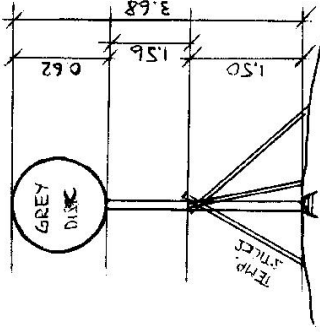

Date	Record of Station

Checked Alan Wood 27/3/19.

