



STATION GEORGE (PILLAR) T.S. 5351

Owners Name.....  
 Current Occupant.....

Address.....  
 Address.....

Access - 6th Sept 1975


CONTINUING OBSERVED DIRECTIONS

STANDPOINT: WARNER NWL

STATION	DIRECTION
RED HILL (PILLAR) T.S.	00 00 00
HUDSON T.S.	352 05 34
TRIG. PILLAR	307 26 53
TRIG. PUG	296 02 08
G.I. PIPE	295 25 00
HUNGRY (PILLAR) T.S.	269 02 25

ACCESS

Not to Scale

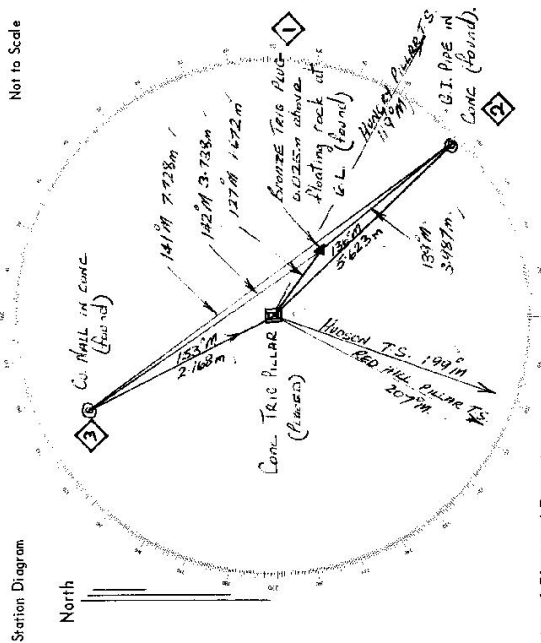

List of Observed Directions:-

Station	Direction	Station	Direction
RED HILL (PILLAR) T.S.	00 00 00	HUDSON T.S.	00 00 00
Cu Nail	127 04 22	G.I. PIPE	295 25 00
HUNGRY (PILLAR) T.S.	269 02 25	HUNGRY (PILLAR) T.S.	269 02 25
TRIG. PUG	296 02 08	Cu Nail	127 04 22
G.I. PIPE	295 25 00	TRIG. PILLAR	307 26 53
HUDSON T.S.	352 05 34	RED HILL (PILLAR) T.S.	00 00 00








STATION GEORGE O.P TS 5351

Owners Name.....  
Current Occupant.....

Address.....  
Address.....

Access SEE REPORT D.KAIN 6/9/75

Original Mark

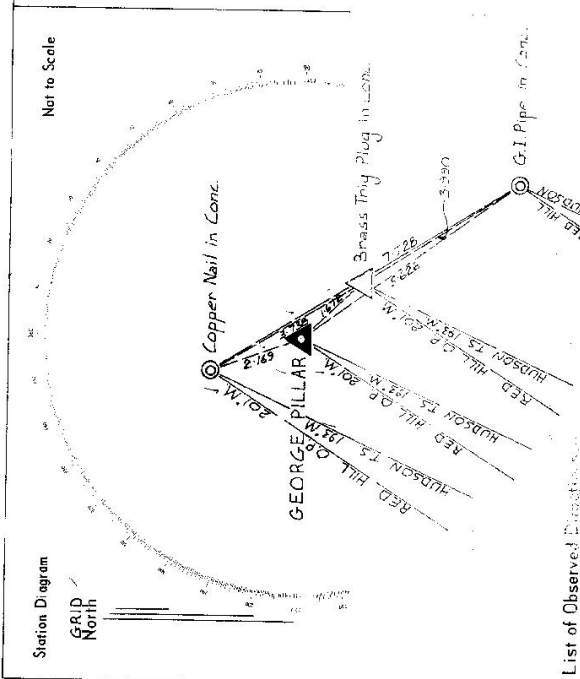

List of Observed Directions

Station	Direction	Station	Direction
HUDSON T.S.	359 59 60	HUDSON T.S.	359 59 60
RED HILL O.P.	7 53 57	RED HILL O.P.	7 53 57
Copper Nail in Conc.	135 29	Pillar Spigot	108 57
Brass Trig Plug in Conc.	288 50	Copper Nail in Conc.	123 55
G.I. Pipe in Conc.	298 34	G.I. Pipe in Conc.	302 44
G.I. Pipe in Conc.			
Station	Direction	Station	Direction
HUDSON T.S.	359 59 60	HUDSON T.S.	359 59 60
RED HILL O.P.	7 53 57	RED HILL O.P.	7 54 35
Pillar Spigot	118 38 30	G.I. Pipe in Conc.	303 20 00
Brass Trig Plug in Conc.	122 43	Brass Trig Plug in Conc.	303 53
Copper Nail in Conc.	123 18 20	Pillar Spigot	315 29

Standpoint: Conc. Observation Pillar

Standpoint: Brass Trig Plug in Conc.

