

STATION 5468 BELMONT (S.P.11AK)

Owners Name: MR. PEEL Current Occupant:

Address: GROSS VALE ROAD Address:

..... NORTH RICHMOND

Access NORTH RICHMOND, 22-8-75

OO INTERSECTION WINDSOR, LITKOW, &
GROSS VALE ROAD.


TAKE GROSS VALE ROAD.

1.0 TS. ON RIGHT SIDE OF ROAD.

Not to Scale

Station Diagram

North

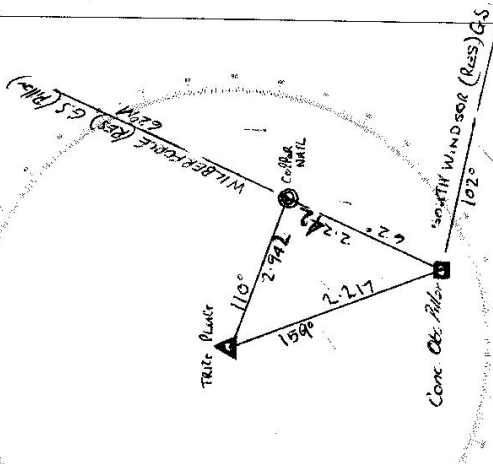

List of Observed Directions:-

Standpoint: CONC OBS PILLAR Standpoint: TRIC PLANT.

Station	Direction	Station	Direction
WILBERFORCE (RES) G.S. PILLAR	274	WILBERFORCE (RES) G.S. PILLAR	274
CONC. PILLAR	57	SOUTH WINDSOR RES	49
SOUTH WINDSOR RES	49	CONC. PILLAR	57
TRIC PLANT	277	CONC. OBS PILLAR	277

Station	Direction	Station	Direction

75-104

Department of Lands
 This Trig. Station has been:-

Integrati Survey of N.S.W.
 RECONNAISSANCE and MAINTENANCE REPORT 8355
 STATION BELMONT PILLAR No. 5469
 Co: COCK Ph: KILGATONB
 Map Sheet: GROSS WOOD No: 6475
 Inspected by: C. PEREMY Date: 31/8/77
 Authority: CMA Field Book: 7611

Note: Cross out word or words which do not apply

1. Completely cleared to permit 360° vision to surrounding Trigs.
2. ~~Cleared by Jones-bearing.~~ from Trig. Mast
3. Trig. Mast & Vanes have been painted white & black respectively.
4. The Trig. was unpiled/not unpiled, dimensions now being:
 Description of mark Concrete Pillar should be explicit, e.g. Steel plug, Brass plug, Bolt, Concrete Pillar

Height of mark.....m above rock, concretem above G.L.
 below below

Height of Top Vanes to Top Mast/Top pillar plate 1.47 m Diameter of Vanes (vertical) 0.75 m.

Height of Cairn.....m. Diameter of Cairn.....m.

Length of Mast 0.72 m. ~~Approximate if not omitted~~

5. A. Brass Plug set in conc/rock has been placed/fd 2.218 m. bearing 338°M from Trig. Mast/pillar

6. A.....set in conc/soil has been placed/fd.....m. bearing.....°M from Trig. Mast/pillar

7. A.....set in conc/soil has been placed/fd.....m. bearing.....°M from Trig. Mast/pillar

8. A.....set in conc/rock has been placed/fd.....m. bearing.....°M from Trig. Mast/pillar

9. Connection.. Pillar to Brass Plug : 2.218 m. bearing 338°M

10. Connection.....to.....m. bearing.....°M

11. Connection.....to.....m. bearing.....°M

12. Connection.....to.....m. bearing.....°M


13. Diff. Ht. Belmont Pillar is 1.44 m. ^{above} Brass Plug _{below}

14. Diff. Ht. is .. m. ^{above} _{below}

15. Diff. Ht. is .. m. ^{above} _{below}

16. Diff. Ht. is .. m. ^{above} _{below}

Prepared by: P. Hayes Checked: A. Sullivan

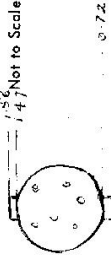


Beacon Diagram

1:4 Not to Scale

0-7.2

0-5.5

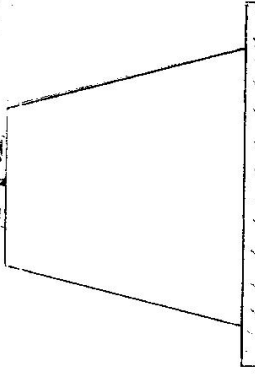

Record of Station

Date 31-8-77 Observations by C Peremy Lines About

