

74-98


Department of Lands  
 RECONNAISSANCE and MAINTENANCE REPORT  
 Triangometrical Survey of N.S.W.

STATION HONWICK (Pillar) T.S. 5470  
 Co: DURHAM Ph: HONWICK ✓  
 Map Sheet: MURSWELLBROOK SOUTH No: 9033  
 Inspected by: DAVID J. HAIN Date: 7th November 1975  
 Authority: \_\_\_\_\_ Field Book: 013-07

This Trig. Station has been:   
 Note: Cross out word or words which do not apply

1. ~~Completely cleared to permit 360° vision to surrounding Trig.~~ ✓
2. Cleared by lanes bearing 110° 87° m. ✓ from Trig. Mast
3. Trig. Mast & Vanes have been painted white & black respectively.
4. The Trig. was unpiled/not unpiled, dimensions now being: Original Mast (1st) found  
 Description of mark: Steel Plug ✓ should be explicit, e.g. Steel plug, Brass plug, Bolt, G.I. Pipe  
 Height of mark: Level Steel concrete G.L.  
 Height of Top Vanes to Top Mark: 1.435 m. Diameter of Vanes (vertical): 0.750 m. ✓  
 Height of Cairn: \_\_\_\_\_ m. Diameter of Cairn: \_\_\_\_\_ m.
5. Length of Mast \_\_\_\_\_ m. (approximate if not unpiled)
6. Concrete set in conc/rock has been placed 2.494 m. bearing 125° ✓ 0M from Trig. Mast
7. Concrete set in conc/rock has been placed 2.687 m. bearing 270° ✓ 0M from Trig. Mast
8. Concrete set in conc/rock has been placed 3.688 m. bearing 192° ✓ 0M from Trig. Mast
9. Concrete set in conc/rock has been placed \_\_\_\_\_ m. bearing \_\_\_\_\_ m. from Trig. Mast
10. Connection Steel Plug to G.I. Pipe: 6.987 m. bearing 126° ✓ ORIGINAL SITUATION MEASUREMENTS BEFORE TRIG. WAS UNPILED
11. Connection Steel Plug to G.I. Pipe: 4.762 m. bearing 254° ✓
12. Connection Steel Plug to G.I. Pipe: 5.139 m. bearing 167° ✓
13. Connection \_\_\_\_\_ to \_\_\_\_\_ m. bearing \_\_\_\_\_ m.
14. Diff. Ht. Steel Pipe is 1.675 m. below PILLAR PLATE
15. Diff. Ht. Copper Nail is 1.847 m. below PILLAR PLATE
16. Diff. Ht. G.I. Pipe is 1.484 m. below PILLAR PLATE
- Diff. Ht. \_\_\_\_\_ is \_\_\_\_\_ m. above below

Prepared by: \_\_\_\_\_ Checked: 11/10/76 Noted on U.T.M. Card

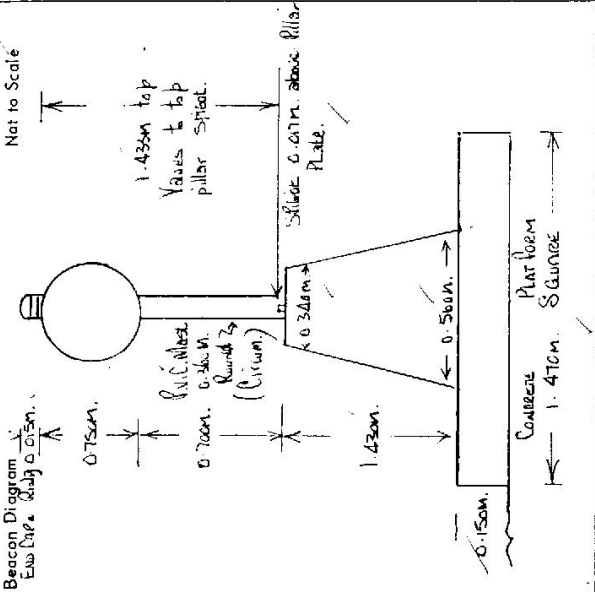

Date	Record of Station

Checked

STATION Howick (Pillar) T.S. 5470

Owners Name: Mr. Ryan  
 Current Occupant: GRANBY

Address: WONDENAI  
 Address:

Phone: LEAMINGTON 743 119


Access 17-11-1975 Access to Howick (Pillar) T.S. From MUSWELLBROOK.  
 AT MUSWELLBROOK POST OFFICE AT 0.0 MILES TRAVEL VIA NEW ENGLAND HIGHWAY TOWARD SINGLETON.

- MILEAGE
- 10.40 (TURN INTO ENTRANCE INTO LIODELL POWER STATION. ✓)
  - 11.15 TAKE SEALED ROAD OFF TO YOUR LEFT. (RED AND WHITE ELECTRICITY COMMISSION SIGN, TO E.C. PUMPING STATIONS) ✓
  - 11.45 PASS UNDER NEW ENGLAND HIGHWAY AT 'TINKERS CREEK'. ✓
  - 11.60 TAKE LEFT FORK IN GRAVEL ROADS. ✓
  - 12.40 PASS ROAD ON YOUR R.H.S. ✓
  - 14.00 PASS WATER PUMPING STATION, FOLLOW MAIN GRAVEL ROAD. ✓
  - 17.40 CONCRETE CAUSEWAY. ✓
  - 19.20 TAKE TRACK OFF TO YOUR LEFT, DOWN BETWEEN TWO STEEL GRIDS. ✓
  - 19.45 CROSS CREEK OVER CONCRETE CAUSEWAY BELOW E.C. PUMPING STATION BUILDING, FOLLOW TRAIL TO YOUR LEFT IN A SOUTH/EAST DIRECTION ✓
  - 20.10 ADDRESS OPEN Paddock. ✓
  - 20.40 THROUGH IRON GATE, FOLLOW TRACK WITH FENCE ON YOUR LEFT. ✓
  - 20.40 THROUGH TWO IRON GATES IN CATTLE YARDS, FOLLOW TRAIL UP GENTLE SLOPE, FENCE STILL ON YOUR LEFT. ✓
  - 21.00 TRIG. PILLAR. ✓

Note: IN DEPT WEATHER IT WOULD BE POSSIBLE TO DRIVE A STATION SEDAN TYPE VEHICLE TO THIS TRIG.

Not to Scale

Station Diagram

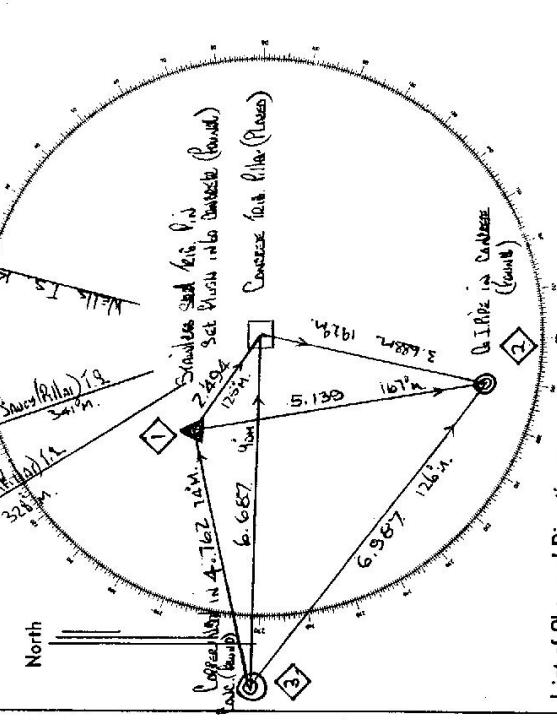

List of Observed Directions:-

Standpoint: Concrete Causeway Near Standpoint - STEEL TRIG PILLAR

Station	Direction	Station	Direction
BELLS T.S.	0 00 00	SANDY PILLAR T.S.	0 00 00
G.I. PIPE	178 17 50	COPPER MAIL	297 06 40
COPPER MAIL	257 11 10	G.I. PIPE	168 24 10
STEEL PILLAR	289 13 30	CONC. OBS. PILLAR	146 18 30
SANDY PILLAR T.S.	322 56 10	BELLS T.S.	57 05 57

COPPER MAIL IN CONCRETE

Station	Direction	Station	Direction
SANDY PILLAR T.S.	0 00 00		
STEEL TRIG PILLAR	98 04 20		
CONC. OBS. PILLAR	114 12 50		
G.I. PIPE	145 24 40		
ARTHUR PILLAR T.S.	346 12 01		

CENTRAL MAPPING AUTHORITY

Department of Lands

Trigonometrical Survey of N.S.W.

RECONNAISSANCE and MAINTENANCE REPORT

7-4-98

STATION **HOWICK O.P. TS 5470**

This Trig. Station has been:-

Note: Cross out word or words which do not apply

1. Completely cleared to permit 360° vision to surrounding Trigs. ✓
2. Cleared by lanes bearing ..... from Trig. Mast
3. Trig. Mast & Vanes have been painted white & black respectively. ✓
4. The Trig. was unpiled/~~not unpiled~~, dimensions now being: .....

Description of mark **Concrete Observation Pillar**, should be explicit, e.g. Steel plug, Brass plug, Bolt, G.I. Pipe

Height of mark ..... m <sup>above</sup> ~~below~~ G.I.

Height of Top Vanes to Top Mark **1.450** m. Diameter of Vanes (vertical) **0.750** m.

~~Height of Cross~~ ..... m. ~~Diameter of Cross~~ ..... m.

Length of Mast **0.700** m. (approximate if not unpiled)

5. **A.G.I. Pipe** set in conc/~~rock~~ has been placed **3.689** m. bearing **188**°M from Trig. Mast

6. **Copper Nail** set in conc/~~rock~~ has been placed **6.686** m. bearing **267**°M from Trig. Mast

7. **ATrig. Pin** set in conc/~~rock~~ has been placed **2.424** m. bearing **299**°M from Trig. Mast

8. **A** set in conc/rock has been placed ..... m. bearing .....°M from Trig. Mast

9. Connection **Trig. Pin to G.I. Pipe** : **5.138** m. bearing **161**°M

10. Connection **Trig. Pin to Copper Nl.** : **4.742** m. bearing **251**°M

11. Connection ..... to ..... : ..... m. bearing .....°M

12. Connection ..... to ..... : ..... m. bearing .....°M

13. Diff. Ht. **G.I. Pipe in Conc.** is **1.485** m. <sup>above</sup> ~~below~~ **Pillar Plate**

14. Diff. Ht. **Copper Nail in Conc.** is **1.947** m. <sup>above</sup> ~~below~~ **Pillar Plate**

15. Diff. Ht. **Trig 3/4 Pin in Conc.** is **1.676** m. <sup>above</sup> ~~below~~ **Pillar Plate**

16. Diff. Ht. ..... is ..... m. <sup>above</sup> ~~below~~ .....

Noted on U.T.M. Card

Prepared by: **C. J. Brown** Checked: **J. Williams**


Co: **DURHAM** Ph: **HOWICK**

Map Sheet: **MUSWELLBROOK - S** No: **9033-5**

Inspected by: **C. J. BROWN** Date: **6<sup>th</sup> January, 1976**

Authority: **C. M. A.** Field Book: **1477**

Beacon Diagram Not to Scale

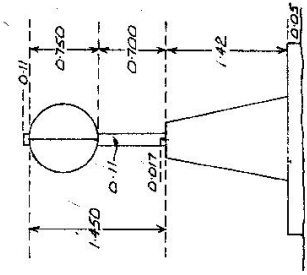

Date	Record of Station

Checked

**C. B. 2/11/76**  
SENIOR TRIGONOMETRICAL SURVEYOR

STATION HOWICK O.P. TS 5470

Current Occupant: .....


Address: .....

Owners Name: .....

Address: .....

Access: .....

Not to Scale

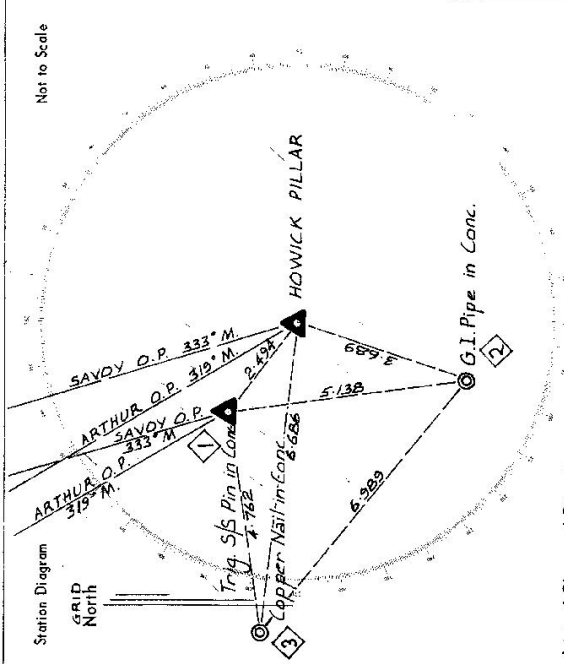

List of Observed Directions:-

Standpoint: Conc. Observation Pillar Standpoint: Trig S/S Pin in Conc.

Station	Direction	Station	Direction
ARTHUR O.P.	353.59.60	ARTHUR O.P.	353.59.60
SAVOY O.P.	13.47.21	SAVOY O.P.	13.47.39
GI. Pipe in Conc.	229.08	Pillar Spigot	140.05
Copper Nail in Conc.	308.02.30	GI. Pipe in Conc.	102.10.30
Trig. S/S Pin in Conc.	340.04	Copper Nail in Conc.	129.54

TS 5470

Department of Lands

Integration by of N.S.W.

RECONNAISSANCE and MAINTENANCE REPORT 2520 STATION **HOWICK (P)** TS **5470**

This Trig. Station has been:-

Note: Cross out word or words which do not apply

1. Completely cleared to permit 360° vision to surrounding Trigs. ✓
2. Cleared by lanes bearing ..... from Trig. Mast
3. Trig. Mast & Vanes have been painted white & black respectively. ✓
4. The Trig. was unpiled/not unpiled, dimensions now being:

Description of mark **CONCRETE PILLAR** should be explicit, e.g. Steel plug, Brass plug, Bolt, Concrete Pillar  
 Height of mark ..... m above rock/concrete **1.41** m above G.L.  
 Height of Top Vanes to Top Mark/Top pillar plate **1.46** m Diameter of Vanes (vertical) **0.76** m.

Height of Cairn **1.41** m. Diameter of Cairn ..... m.

Length of Mast **1.58** m. (approximate if not unpiled)

5. A **S.S.** Trig. Ring set in conc/rock has been placed/rd **2.420** m. bearing **314** °M from Trig. Mast/pillar
6. A **G.I.P.** set in conc/soil has been placed/rd **3.687** m. bearing **190** °M from Trig. Mast/pillar
7. A **C.S.** set in conc/soil has been placed/rd **6.684** m. bearing **263** °M from Trig. Mast/pillar
8. A set in conc/rock has been placed/rd ..... m. bearing ..... °M from Trig. Mast/pillar

9. Connection Trig plug to **G.I.P.** **5.133** m. bearing **165** °M

10. Connection Trig plug to **C.S.** **4.758** m. bearing **253** °M

11. Connection to ..... m. bearing ..... °M

12. Connection to ..... m. bearing ..... °M

13. Diff. Ht. **Pillar plate** is **1.676** m. above **55 Trig plug**

14. Diff. Ht. **Pillar plate** is **1.478** m. above **G.I.P.**


15. Diff. Ht. **Pillar plate** is **1.843** m. above **C.S.**

16. Diff. Ht. **Trig. plug** is **0.165** m. above **C.S.**

Prepared by: **P. McBRACK**

Checked: **A. BURROWS**

Co: **DURHAM** Ph: **HOWICK**  
 Map Sheet: **MUSWELLBROOK** No: **2033**  
 Inspected by: **P. McBRACK** Date: **22-3-76**  
 Authority: **I.S.D. Newcastle** Field Book: **P.D.P. 334**  
 Beacon Diagram Not to Scale

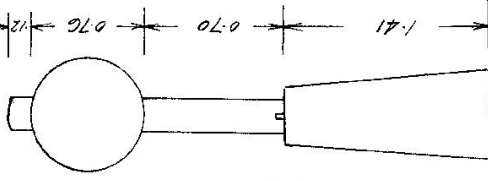

Height of Pillar Spiked **0.015** m.

Date	Record of Station
17-11-75	Pillar Placed.

STATION **HOWICK (P) TS 5470**


Owners Name: **Herovic Pastoral Co.** Current Occupant: .....

Address: ..... Address: .....

Access: **22-3-1976**

\* Accessible by 2 wheel drive vehicle to within 3 min walk of Trig.  
 in Dry weather conditions only.  
 From Singerton take New England Hwy towards Muswellbrook  
 Take turn off to Liddell Power Stn.

- Notes:
- 00. Liddell Power Station turn off on New England Hwy
  - 1-5. Take left turn onto road that follows pipeline through subway under New Eng Hwy. (near power stn)
  - 2-0. Pass turn off on right that follows pipeline, follow good gravel road.
  - 9-15. Pass dirt road on left that leads to Jerry's Plains.
  - 11-35. Conc. causeway.
  - 14-2. Turn left off road between two iron grids and head south towards pumping station along faint track.
  - 14-6. Cross conc. causeway near pumping stn and turn left up hill. Pick your own way up hill gradually veering towards fence on right.
  - 15-6. Through iron gate, follow fence to cattle yards.
  - 16-0. Drive to southern end of cattle yards and through 3 iron gates. Follow fence to Trig.
  - 16-7

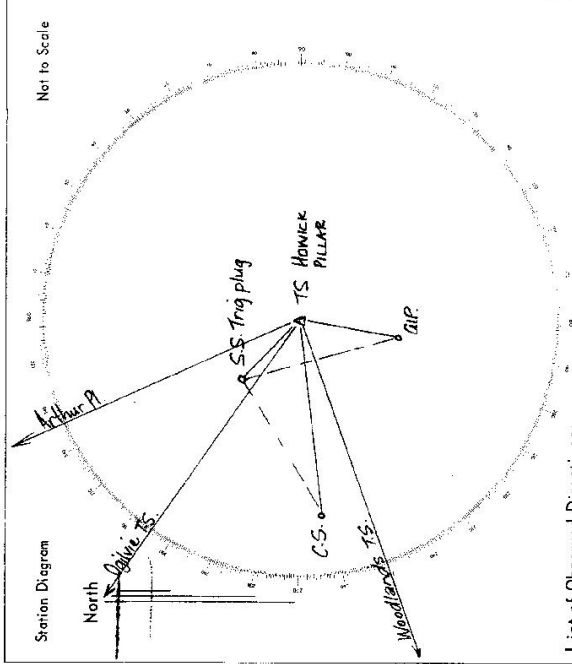

List of Observed Directions:-

Station	Direction	Station	Direction
TS Arthur P.	0° 00' 00"	Standpoint: S.S. Trig plug	0° 00' 00"
G.I.P.	229° 07' 07"	TS Arthur P.	160° 09' 36"
Woodlands T.S.	286° 56' 21.5"	HOWICK PILLAR	292° 10' 28"
C.S.	308° 02' 19.5"	G.I.P.	296° 55' 09.5"
Opaline T.S.	331° 08' 15.5"	Woodlands T.S.	181° 54' 48.5"
C.S.		C.S.	
S.S. Trig plug	340° 04' 49.5"	Opaline T.S.	351° 08' 00"

CENTRAL MAPPING AUTHORITY

GEODETIC SURVEY OF N.S.W.

GEODETIC STATION RECONNAISSANCE and MAINTENANCE REPORT

STATION: HOWICK (P) No.: 5470

Description: Cleared by lanes bearing.....

MAP SHEET SCALE 1:250 000 Singleton

1. Mast & Vanes have been painted white & black respectively.

INSPECTED BY: DATE: 16.11.77 FIELD BOOK:

3. The station/pillar was unpiled/not unpiled/constructed on..... 19....., dimensions now being:

Description of mark..... should be explicit, e.g., S/Steel Pillar Plate, Steel plug, Brass plug, Bolt, G.I. Pipe

Height of mark.....m, above, below, rock/concrete; Mark is.....m, above, below G.L.

Height of Top Vanes to Top Mark/Pillar plate.....m. Diameter of Vanes (vertical).....m.

Height of Cairn.....m. Diameter of Cairn.....m. Name Plate found/not found/placed.

Length of Mast.....m. (approximate if not unpiled)


4. A.....set in conc/rock has been placed/found, bearing.....° M from Mast/Plug/Pillar

5. A.....set in conc/rock has been placed/found, bearing.....° M from Mast/Plug/Pillar

6. A.....set in conc/rock has been placed/found, bearing.....° M from Mast/Plug/Pillar

7. A.....set in conc/rock has been placed/found, bearing.....° M from Mast/Plug/Pillar

8. Action required:.....

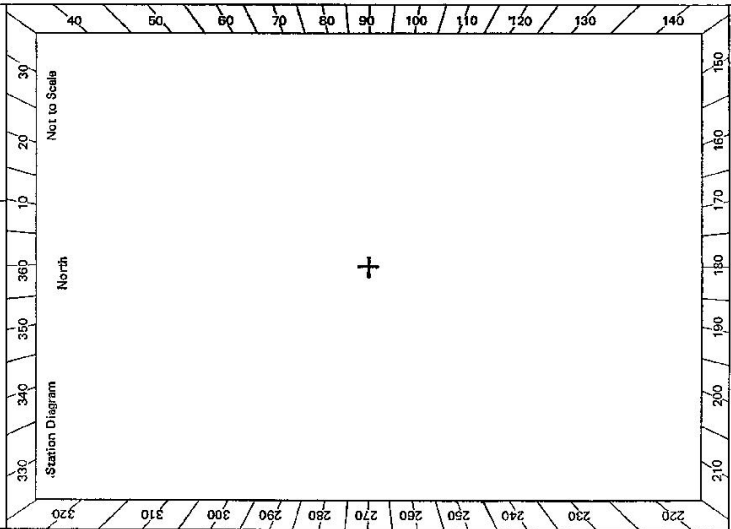


STANDPOINT:				STANDPOINT:			
Mark	Direction	Horiz. Distance	Height Difference	Mark	Direction	Horiz. Distance	Height Difference
			above standpt.				above standpt.
			below standpt.				below standpt.
			above standpt.				above standpt.
			below standpt.				below standpt.
Prepared by: ..... Checked: ..... Noted on U.T.M. Card

STATION HOWICK (P) TS 5470

Access report of 16.11.77

0.00kms Ravensworth P.O. Head south towards Singleton  
 1.0 Make right turn "Lemington 11"  
 2.9 Grid. Continue along road crossing 11 grids  
 16.8 Grid and end of bitumen.  
 17.4 Grid  
 17.45 Two tracks out to right, take sharper of two  
 18.8 Gate  
 19.6 Gate. Ignore tracks to both sides .. keep on going straight  
 20.1 ahead.  
 21.8 Pass under power line  
 22.7 Turn left before gate and follow fence  
 24.3 Yards...see sketch  
 24.4 Leave yards and follow fence on LHS in an easterly direction.  
 25.3 HOWICK (P)

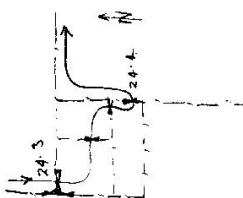

SKETCH

51,2735-2 D. West, Government Printer

Beacon Diagram	Not to Scale

This section to be completed by officer constructing pillar.

Original station mark found/not found.

Description of mark: .....

Original beacon found/not found.

Description of beacon: .....

Height Top of Vanes to Top Mark.....m.

Height of mark.....m. above G.L. below

Diameter of Vanes .....m. Height of Cairn .....m.

Original Beacon has/has not been destroyed by me.

Date	Record of Station
16.11.77	Trig visited. Access updated.