

71.98

CENTRAL MAPPING AUTHORITY
Department of Lands

Trigonometrical Survey of N.S.W.
RECONNAISSANCE and MAINTENANCE REPORT

STATION BAKARA SPUR 5486
(Pillar) J.S.

Co: NORTHUMBERLAND Ph: ALLALONG

Map Sheet: CESSENOCK (S) No: 9132

Inspected by: DAVID J. KEENE Date: 27 AUGUST 1975

Authority: C.M.A. Field Book: U1394

Beacon Diagram Not to Scale

This Trig. Station has been:-

Note: Cross out word or words which do not apply

1. Completely cleared to permit 360° vision to surrounding Trigs.
2. Cleared by lanes bearing..... from Trig. Mast
3. Trig. Mast & Vanes have been painted white & black respectively.
4. The Trig. was unpiled/not unpiled, dimensions now being:

Description of mark..... should be explicit, e.g. Steel plug, Brass plug, Bolt, G.I. Pipe

Height of mark..... m ^{above} rock/concrete m ^{below} G.L.

Height of Top Vanes to Top Mark..... m. Diameter of Vanes (vertical)..... m.

Height of Cairn..... m. Diameter of Cairn..... m.

Length of Mast..... m. (approximate if not unpiled)

5. A..... set in conc/rock has been placed..... m. bearing.....°M from Trig. Mast
6. A..... set in conc/soil has been placed..... m. bearing.....°M from Trig. Mast
7. A..... set in conc/soil has been placed..... m. bearing.....°M from Trig. Mast
8. A..... set in conc/rock has been placed..... m. bearing.....°M from Trig. Mast
9. Connection..... to..... m. bearing.....°M
10. Connection..... to..... m. bearing.....°M
11. Connection..... to..... m. bearing.....°M
12. Connection..... to..... m. bearing.....°M
13. Diff. Ht. is..... m. ^{above} below
14. Diff. Ht. is..... m. ^{above} below
15. Diff. Ht. is..... m. ^{above} below
16. Diff. Ht. is..... m. ^{above} below

Prepared by: _____ Checked: _____

Noted on U.T.M. Card


Checked

Date _____ Record of Station _____

STATION BARRABA SPUR O.P. 5486

Owners Name.....
 Current Occupant.....
 Address.....
 Address.....

Access 15-10-1975

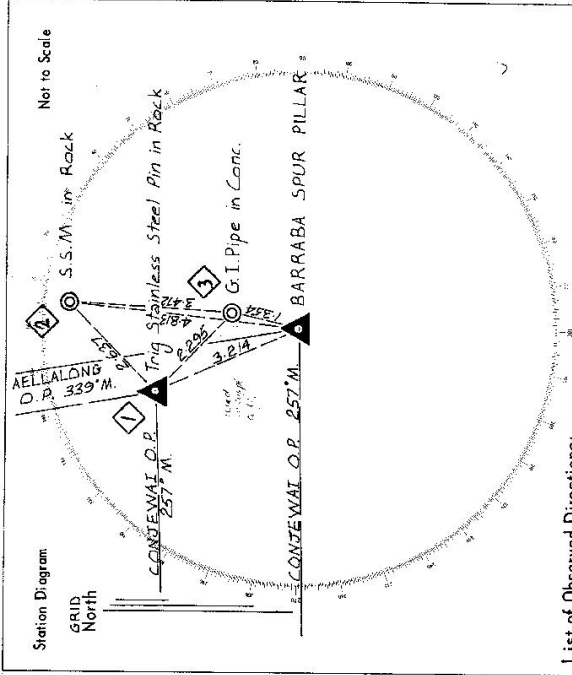

List of Observed Directions:-

Standpoint: Conc. Observation Pillar Standpoint: Trig Stainless Steel Pin in Rock

Station	Direction	Station	Direction
CONJEWAI O.P.	353.53.60	CONJEWAI O.P.	353.53.60
Trig S.S. Pin in Rock	67.08	AELLALONG O.P.	81.56.02
AELLALONG O.P.	81.54.00	S.S.M. in Rock	136.54
S.S.M. in Rock	89.03	G.I. Pipe in Conc.	226.03
G.I. Pipe in Conc.	104.39	Pillar Spigot	247.08

Station	Direction	Station	Direction