

STATION TYNLYNDER PILLAR TS. 5507

Current Occupant.....

Address.....

Owners Name: ~~John~~ HATFIELD.

Address.....

Access B-21 / 10 / 175


FEATURE

- INWERELL. head west along GUYDIA HWY.
- Bridge over Marintyre River.
- Turn right toward YETMANS.
- Railway crossing.
- " "
- " "
- Turn left sign says "16km MT RUSSELL".
- Keep on bitumen
- Turn right onto gravel road towards "MARVADA STUD"
- Turn right off road thru iron gate "MARELWA"
- Turn right immediately thru gate
- Thru fence line + veer left along faint track
- AT TRIG. ▲ on top of flat open ridge

- K.M
- 0.0
- 0.7
- 2.9
- 3.9
- 5.9
- 16.2
- 24.1
- 26.8
- 28.9
- 29.0
- 29.4

Not to Scale

Station Diagram
magnetic
North

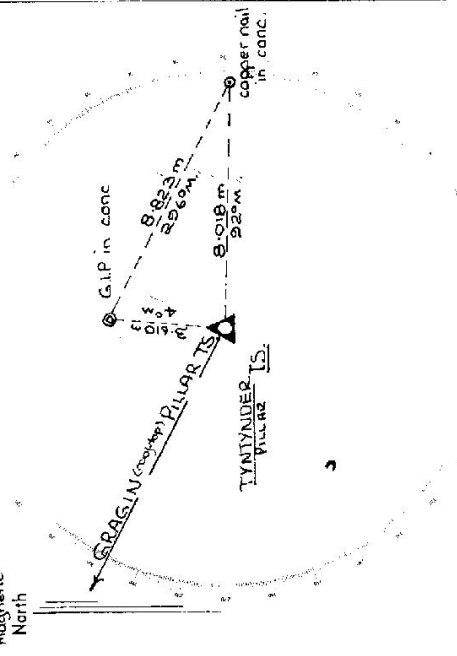

List of Observed Directions:-

Station	Direction	Station	Direction
GRAGIN PILLAR TS	359° 53' 60"	GRAGIN PILLAR TS	359° 53' 60"
G.I.P. in conc. fid	69° 21'	Copper nail in conc	184° 04' 30"
Copper nail in conc fid	189° 54' 30"	Pillar plate	248° 23'
STANDPOINT: Copper nail in conc			
Station	Direction	Station	Direction
GRAGIN PILLAR TS	359° 53' 60"		
G.I.P. in conc fid	4° 04' 30"		
Pillar Plate	238° 55' 00"		

CENTRAL MAPPING AUTHORITY

GEODETIC SURVEY OF N.S.W

GEODETIC STATION RECONNAISSANCE and MAINTENANCE REPORT

Description:

Note: Cross out word or words which do not apply

1. Cleared by lanes bearing..... from Trig. Mast
2. Mast & Vanes have been painted white & black respectively.
3. The station/pillar was ~~unplaced~~/not unplaced/constructed on..... 19....., dimensions now being:
 Description of mark..... should be explicit, e.g., S/Steel Pillar Plate, Steel plug, Brass plug, Bolt, G.I. Pipe
 Height of mark.....m. ^{above} rock/concrete; Mark is.....m. ^{above} _{below} G.L. (2)
 Height of Top Vanes to Top Mark/Pillar plate.....m. Diameter of Vanes (vertical).....m.
 Height of Cairn.....m. Diameter of Cairn.....m. Name Plate found/not found/placed.
 Length of Mast.....m. (approximate if not unplaced) 5
4. A..... set in conc/rock has been placed/found, bearing.....°M from Mast/Plug/Pillar
5. A..... set in conc/rock has been placed/found, bearing.....°M from Mast/Plug/Pillar
6. A..... set in conc/rock has been placed/found, bearing.....°M from Mast/Plug/Pillar
7. A..... set in conc/rock has been placed/found, bearing.....°M from Mast/Plug/Pillar
8. Action required: ~~no action required~~

STANDPOINT:

Mark	Direction	Horiz. Distance	Height Difference	Mark	Direct on	Horiz. Distance	Height Difference
			above standpt.				above standpt.
			below standpt.				below standpt.
			above standpt.				above standpt.
			below standpt.				below standpt.
			above standpt.				above standpt.
			below standpt.				below standpt.
			above standpt.				above standpt.
			below standpt.				below standpt.

Prepared by: K. Z. 9/1/22 Checked: Noted on U.T.M. Card

ST 2733-1

STATION: **TYNANDYER G.SOP** No.: **5507**

MAP SHEET SCALE 1:250 000

INSPECTED BY: **J. Frecht, K. Z. N** DATE: **13/22**

AUTHORITY: **67/2/11** FIELD BOOK:

Station Diagram

Not to Scale

CENTRAL MAPPING AUTHORITY

GEODETIC SURVEY OF M.S.W.

GEODETIC STATION RECONNAISSANCE and MAINTENANCE REPORT

STATION: **TYNTRYNDYVER (P)** No.: **5507**
 MAP SHEET SCALE 1:250 000
 INSPECTED BY: **G FORD** DATE: **1-8-84**
 AUTHORITY: **C M A** FIELD BOOK: **C 377**

- Description:
- Cleared by lanes bearing $215^{\circ} 28'$ $355'$ $1^{\circ} 46'$ $55'$ $6^{\circ} 7'$ $7^{\circ} 36'$ $6^{\circ} 10'$ from Trig. Mast
 160° 17' LINES AT 290, 308, 36, 156.
 - Mast & Vanes have been painted white & black respectively. ✓
 - The station/pillar was unpiled/~~not-empiled~~ constructed on 1.8 19.84 , dimensions now being:
 Description of mark: ~~PLATE~~ ~~MAST~~ should be explicit, e.g., S/Steel Pillar Plate, Steel Plug, Brass Plug, Bolt, G.I. Pipe
 Height of mark: 1.410 m. ^{above} rock/concrete; Mark is 1.410 m. ^{above} G.L.
 Height of Top Vanes to Top Mast/Pillar plate 1.440 m. Diameter of Vanes (vertical) 0.750 m.
 Height of Cairn:m. Diameter of Cairn:m. Name Plate found/~~not-found~~/placed.
 Length of Mast:m. (approximate if not unpiled)
 - A ~~CONCRETE~~ ~~MAST~~ set in conc/rock has been placed/found, bearing 92° $0'$ M from Mast/Plug/Pillar
 - A ~~G.I.~~ ~~PIPE~~ set in conc/rock has been placed/found, bearing $1^{\circ} 0'$ M from Mast/Plug/Pillar
 - A set in conc/rock has been placed/found, bearing M from Mast/Plug/Pillar
 - A set in conc/rock has been placed/found, bearing M from Mast/Plug/Pillar
 - Action required:

STANDPOINT: CONCRETE PILLAR			STANDPOINT: COPPER MAIL				
Mark	Direction	Horiz. Distance	Height Difference	Mark	Direction	Horiz. Distance	Height Difference
STIRLING (P)	0 00 00		above standpt.	STIRLING (P)	0 00 00		above standpt.
GRACIN (P)	128 43 20		above standpt.	CONC PILLAR	108 35 50	8.830	1.454
G I PIPE	198 04 40	3.611	below standpt.	GRACIN (P)	128 39 40		below standpt.
COPPER MAIL	288 39 00	8.822	below standpt.	G I PIPE	132 44 10	8.830	0.018
TULLOCHARD (P)	325 18 40		above standpt.	TULLOCHARD (P)	325 16 40		below standpt.
			below standpt.				below standpt.
			above standpt.				above standpt.
			below standpt.				below standpt.

Prepared by: *[Signature]* 15/8/84. Noted on U.T.M. Card *[Signature]*
 Checked: *[Signature]* 6/1/84

<p>6-2732-2 O. West, Government Printer</p> <p>Beacon Diagram</p>		<p>STATION TINTYNDYER (P) TS 5507</p> <p>ACCESS OWNER CURRENT OCCUPANT: MR N. GREEN</p> <p>Address: K. VALLERNA</p> <p>Phone: MT. RUSSELL</p> <p>Owner's Name: MR. J. NESBITT</p> <p>Address: HILL HOLLOW, MT. RUSSELL</p> <p>Phone: 0745 573 156 (DARPAAS)</p> <p>Address: MT. RUSSELL</p> <p>Phone: MT. RUSSELL 51</p> <p>ACCESS</p> <p>Access Report of L.S. 1984 was found suitable/unsuitable.</p> <p>0.00 BRIDGE OVER MACINTYRE RIVER INVERELL HEAD WEST TOWARDS WARIMODA</p> <p>0.7 TURN RIGHT TOWARDS YETHAM</p> <p>2.9 x 3.9 x 5.9 RAILWAY CROSSING</p> <p>16.2 TURN LEFT "MR RUSSELL 16"</p> <p>24.1 KEEP ON BITUMEN</p> <p>26.8 TURN RIGHT ONTO GRANITE RD. "MACALUDA STOP"</p> <p>28.9 TURN RIGHT THROUGH IRON GATE "WYLLIHA" THEN MAKE RIGHT</p> <p>MR GREEN LINES STRAIGHT AHEAD OVER HILL</p> <p>28.95 DOUBLE IRON GATES HEAD UP TO IRON GATE NEAR SADDLE</p> <p>29.2 IRON GATE HEAD UP TO SADDLE</p> <p>29.4 TINTYNDYER C.S. ON LONG FLAT HILL</p>
		<p>Date</p> <p>Record of Station</p>

This section to be completed by officer constructing pillar.

Original station mark found/not found.

Description of mark:

Original beacon found/not found.

Description of beacon:

Height Top of Vanes to Top Mark.....m.

Height of mark.....m. above G.L.
below

Diameter of Vanes.....m. Height of Cairn.....m.

Original Beacon has/has not been destroyed by me.