




STATION WOME RAH TS 5516

Owners Name.....  
 Current Occupant.....  
 Address.....  
 Address.....  
 Access.....

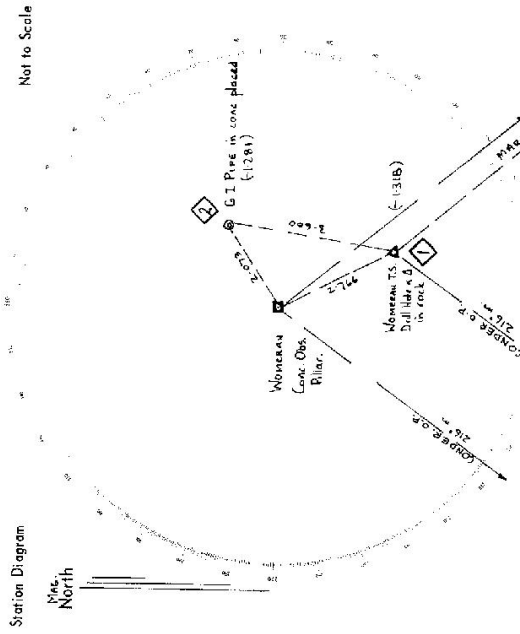

List of Observed Directions:-

Station	Direction	Station	Direction
CONDR. O.P.	353° 59' 40"	CONDR. O.P.	353° 59' 40"
Womehan Pillar Spigg	115° 56'	GI Pipe	200° 58'
GI Pipe	150° 58'	Marsora O.P.	284° 55' 05"
Marsora O.P.	284° 54' 42"	Womehan TS. Pillar	295° 56'
Standpoint: Drill Hole in rock	147° 31'	Standpoint: Conc. Observation Pillar	
Womehan TS. Drill hole in rock	77° 2'		

Station Diagram  
 Not to Scale  
 True North