

74-28

TRIGONOMETRICAL SURVEY OF N.S.W.

CENTRAL MAPPING AUTHORITY

Department of Lands

RECONNAISSANCE and MAINTENANCE REPORT

STATION **BOOTINGWA 5521**

Co: **GROUNDS** Ph: **BOOTEENAAA**

Map Sheet: **WINGHAM** No: **9334 S**

Inspected by: **L. R. HOLLIS** Date: **11th May 1976**

Authority **1393** Field Book: **1393**

Beacon Diagram **Not to Scale**

This Trig. Station has been:- Note: Cross out word or words which do not apply

1. Completely cleared to permit 360° vision to surrounding Trigs. ✓
2. Cleared by lanes bearing **360°** from Trig. Mast
3. Trig. Mast & Vanes have been painted white & black respectively. ✓
4. The Trig. was unpiled/not-empld, dimensions now being: **0.8855 m** ^{above} **0.755** ^{below} **0.8855** should be explicit, e.g. Steel plug, Brass plug, Bolt, G.I. Pipe

Description of mark **Steel/concrete** Diameter of Vanes (vertical) **.255** m. **G.L.**

Height of mark **.04** m ^{above} **.700** m ^{below}

Height of Top Vanes to Top **0.425** m. Diameter of Vanes (vertical) **.255** m.

Height of **0.376** m. Diameter of Cairn **0.376** m. *Pillar Constructed 29.3.76*

5. A. S.S.M. ^{found} set in conc/seek has been placed **5.455** m. bearing **72a°** ^{9M} from Trig. Mast
6. A. C.I. Pipe ^{found} set in conc/seek has been placed **4.570** m. bearing **200°** ^{9M} from Trig. Mast
7. A. T.I. Pipe ^{found} set in conc/seek has been placed **3.720** m. bearing **440°** ^{9M} from Trig. Mast
8. A. set in conc/rock has been placed **0.000** m. bearing **0°** from Trig. Mast

9. Connection **S.S.M. to C.I. Pipe** : **5.450** m. bearing **83°** ^{9M}

10. Connection **S.S.M. to T.I. Pipe** : **2.250** m. bearing **117°** ^{9M}

11. Connection **C.I. Pipe to T.I. Pipe** : **4.035** m. bearing **202°** ^{9M}

12. Connection **to** : **0.000** m. bearing **0°**

13. Diff. Ht. **is** **0.000** m. ^{above} _{below}

14. Diff. Ht. **is** **0.000** m. ^{above} _{below}

15. Diff. Ht. **is** **0.000** m. ^{above} _{below}


16. Diff. Ht. **is** **0.000** m. ^{above} _{below}

Prepared by:

Noted on U. T. M. Card

Checked:

Checked

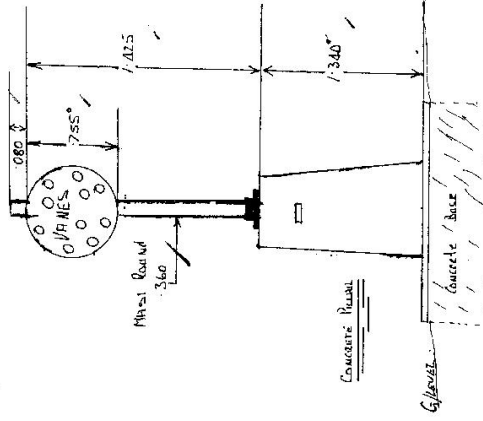

Date


Record of Station

STATION **Boo Tabawa T.S.O.P** **5521**

Owners Name.....
 Current Occupant.....

Address.....
 Address.....

Access 18-5-76

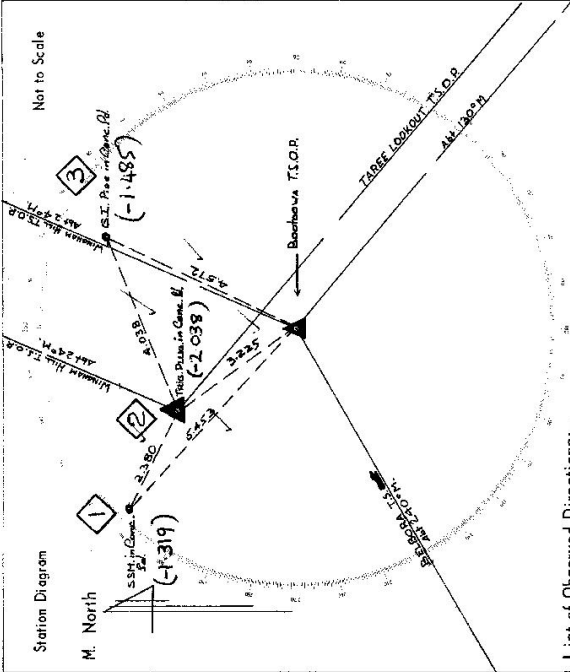

List of Observed Directions:-

Station	Direction	Station	Direction
TARGE LOOKOUT T.S.O.P.	359° 53' 40"	TARGE LOOKOUT T.S.O.P.	359° 53' 40"
BELBOUR T.S.O.P.	110° 07' 50"	PILLAR S.P.L.G.G.O.T.	142° 15'
SSM in Conc. B	182° 48' 00"	SSM in Conc. B	182° 12'
Brass Peg in Conc. B	199° 14'	S.I. Pipe in Conc. B	227° 03'
S.I. Pipe in Conc. B	253° 40'	WINGHAM HILL T.S.O.P.	253° 33' 10"
WINGHAM HILL T.S.O.P.	253° 33' 52"		

Standpoint: Brass Peg in Conc. B

Standpoint: Conc. Obs. Pillar