

CENTRAL MAPPING AUTHORITY

Department of Lands

Trigonometrical Survey of N.S.W.

RECONNAISSANCE and MAINTENANCE REPORT

This Trig. Station has been:-

Note: Cross out word or words which do not apply

1. Completely cleared to permit 360° vision to surrounding Trigs. ✓
2. Cleared by lances bearing ✓
3. Trig. Mast & Vanes have been painted white & black respectively. ✓
4. The Trig. was unpiled/~~not unpiled~~, dimensions now being: ✓

Description of mark..... *20955. 2046* m above ~~rock~~/*concrete* should be explicit, e.g. Steel plug, Brass plug, Bolt, G.I. Pipe
 Height of mark..... *0.40* m above ~~rock~~/*concrete* *260* m ~~above~~ *below* G.L.
 Height of Top Vanes to Top ~~mark~~ *1.44* m. Diameter of Vanes (vertical)..... *255* m.
 Height of ~~stone~~ *1.242* m. Diameter of Cairn m. *PILAR CONSTRUCTED 5.2.76*
 Length of Mast m. (approximate if not unpiled)

5. A. *S.S.M.* set in conc/~~rock~~ has been ~~placed~~ *found* *2.735* m. bearing *276*° m from Trig. Mast
6. A. *2046* *2.44* set in conc/~~soil~~ has been ~~placed~~ *found* *2.440* m. bearing *323*° m from Trig. Mast
7. A. set in conc/~~soil~~ has been placed m. bearing m from Trig. Mast
8. A. set in conc/~~rock~~ has been placed m. bearing m from Trig. Mast

9. Connection..... *S.S.M.* to *2046* *2.700* m. bearing *266*° m
10. Connection..... to m. bearing m
11. Connection..... to m. bearing m
12. Connection..... to m. bearing m
13. Diff. Ht. is m. ~~above~~ *below*
14. Diff. Ht. is m. ~~above~~ *below*
15. Diff. Ht. is m. ~~above~~ *below*
16. Diff. Ht. is m. ~~above~~ *below*

Prepared by:

Checked:

Noted on U.T.M. Card

STATION

LAURIETON TS 5545

Co: *MACQUARIE*

Phi: *CAMDEN HAVEN*

Map Sheet: *CAMDEN HAVEN*

No: *9434*

Inspected by: *L.R. HOLLIS*


Date: *15th May 1976*

Authority

Field Book: *1353*

Beacon Diagram

Not to Scale

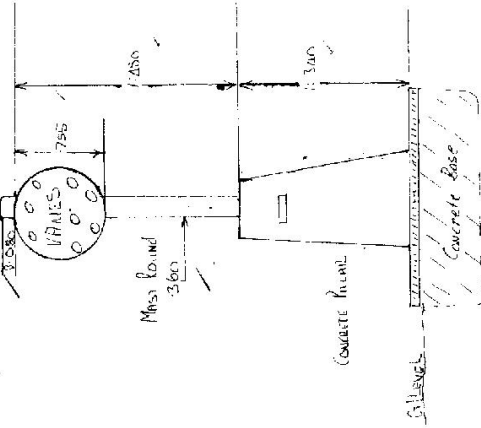

Date

Record of Station

Checked

GEODETTIC SURVEY OF N.S.W.

CENTRAL MAPPING AUTHORITY

GEODETTIC STATION RECONNAISSANCE and MAINTENANCE REPORT

STATION: LAURIE TON GS(P)	No.: 5545
MAP SHEET SCALE 1:250,000	HASTINGS
INSPECTED BY: G JONES	DATE: 10-5-79
AUTHORITY: CMA	FIELD BOOK: —

- Description:
- Note: Cross out word or words which do not apply*
1. Cleared by lanes bearing..... **DAMAGED**..... from Trig. Mast
 2. Mast & Vanes have been **printed white & black** respectively.
 3. The station/pillar was unpiled/not unpiled/constructed on..... 19....., dimensions now being:
Description of mark..... should be explicit, e.g., S/Steel Pillar Plate, Steel plug, Brass plug, Bolt, G.I. Pipe
Height of mark..... m. ^{above} rock/concrete; Mark is..... m. ^{above} G.L.
 - Height of Top Vanes to Top Mark/Pillar plate..... m. Diameter of Vanes (vertical)..... m.
 - Height of Cairn..... m. Diameter of Cairn..... m. Name Plate found/not found/placed.
 - Length of Mast..... m. (approximate if not unpiled)
 4. A..... set in conc/rock has been placed/found, bearing..... M from Mast/Plug/Pillar
 5. A..... set in conc/rock has been placed/found, bearing..... M from Mast/Plug/Pillar
 6. A..... set in conc/rock has been placed/found, bearing..... M from Mast/Plug/Pillar
 7. A..... set in conc/rock has been placed/found, bearing..... M from Mast/Plug/Pillar
 8. Action required: **New mast, cap and flange required.**

STANDPOINT:

Mark	Direction	Horiz. Distance	Height Difference	Mark	Direction	Horiz. Distance	Height Difference
			above standpt.				above standpt.
			below				below
			above standpt.				above standpt.
			below				below
Prepared by: *G Jones* Checked: *G Jones*

Noted on U.T.M. Card



Sr 2733-2 D. Wmsr. Government Printer

STATION LAURIE-TON GS. (P) TS 5545	Owner's Name: Address: Phone: Access Report of 15.5.1976 was found suitable/ unsuitable .	Current Occupant: Address: Phone:	
Beacon Diagram Not to Scale 	This section to be completed by officer constructing pillar. Original station mark found/not found. Description of mark: Original beacon found/not found. Description of beacon: Height Top of Vanes to Top Markm. Height of markm. above G.L. below Diameter of Vanesm. Height of Cairnm. Original Beacon has/has not been destroyed by me.		
		Record of Station	Date

STATION LAURIETON T.S.O.P 5545


Owners Name: Current Occupant:

Address: Address:

Access:

Not to Scale

Station Diagram

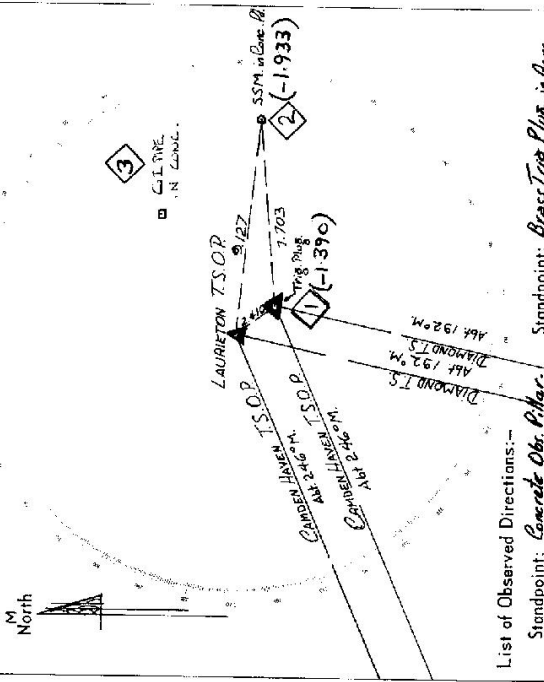

List of Observed Directions:-

Station	Direction	Station	Direction
DIAMOND T.S.	$359^{\circ} 59'$ 400	DIAMOND T.S.	$359^{\circ} 59'$ 400
CAMDEN HAVEN T.S.O.P.	$246^{\circ} 41'$ 246	CAMDEN HAVEN T.S.O.P.	$246^{\circ} 41'$ 246
SSM in Cont. Pl.	$131^{\circ} 52'$ 131.52	After Signal	$131^{\circ} 52'$ 131.52
Breast Trig Png. in Cont. Pl.	$311^{\circ} 46'$ 311.46	SSM in Cont. Pl.	$327^{\circ} 05'$ 327.05

Standpoint: Concrete Obel. Pillar.

Standpoint: Breast Trig Png. in Cont.

Station	Direction	Station	Direction

GEODETTIC SURVEY OF N.S.W.

CENTRAL MAPPING AUTHORITY

GEODETTIC STATION RECONNAISSANCE and MAINTENANCE REPORT

Description:

1. Cleared by lanes bearing.....
Note: Cross out ward or words which do not apply from Trig, Mast
2. Mast & Vanes have been painted white & black respectively.
3. The station/pillar was unpiled/not unpiled/constructed on.....19....., dimensions now being:
Description of mark.....should be explicit, e.g., S/Steel Pillar Plate, Steel plug, Brass plug, Bolt, G.I. Pipe
Height of mark.....m. above rock/concrete; Mark is.....m. above below G.L.
Height of Top Vanes to Top Mark/Pillar plate.....m. Diameter of Vanes (vertical).....m.
Height of Cairn.....m. Diameter of Cairn.....m. Name Plate found/not found/placed.
Length of Mast.....m. (approximate if not unpiled)
4. A.....set in conc/rock has been placed/found, bearing.....°M from Mast/Plug/Pillar
5. A.....set in conc/rock has been placed/found, bearing.....°M from Mast/Plug/Pillar
6. A.....set in conc/rock has been placed/found, bearing.....°M from Mast/Plug/Pillar
7. A.....set in conc/rock has been placed/found, bearing.....°M from Mast/Plug/Pillar
8. Action required:.....

STANDPOINT:

Mark	Direction	Horiz. Distance	Height Difference	Mark	Direction	Horiz. Distance	Height Difference
			above standpt.				above standpt.
			below standpt.				below standpt.
			above standpt.				above standpt.
			below standpt.				below standpt.
Prepared by:

R. J. G. 5/9/79

Checked:

Noted on U.T.M. Card

ST 2738-1

STATION: *Amethyst House* No.: *5545*


MAP SHEET SCALE 1:250 000

INSPECTED BY: *C.R. PARKES* DATE: *4-8-79*

AUTHORITY: *C.M.A.* FIELD BOOK: *168/*

Station Diagram

Checked

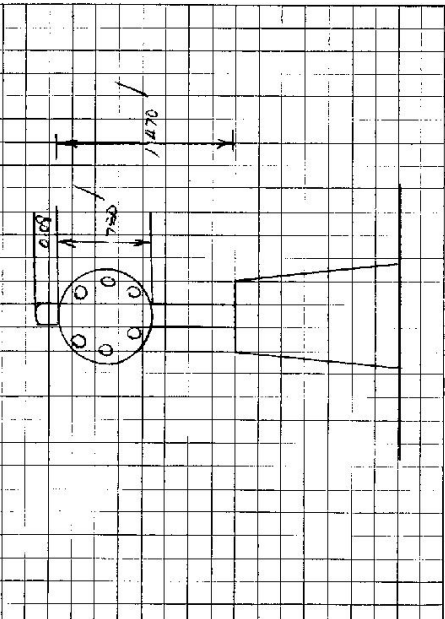S4 2733-2 D. West, Government Printer Beacon Diagram	Not to Scale 	STATION <u>LAURENCE ROAD TS 5545</u> Owner's Name: Address: Phone: Current Occupant: Address: Phone: Access Report of/...../19.....was found suitable/unavailable. ACCESS
This section to be completed by officer constructing pillar. Original station mark found/not found. Description of mark: Original beacon found/not found. Description of beacon: Height Top of Vanes to Top Markm. Height of markm. above G.L. / below rock/concm. below Diameter of Vanesm. Height of Cairnm. Original Beacon has/has not been destroyed by me.		Date Record of Station