










Department of Lands  
 Integration of N.S.W.  
 RECONNAISSANCE and MAINTENANCE REPORT 29392

STATION **MARWOOD (P)** 5548

Co: **Durham** Ph: **Marwood**  
 Map Sheet: **Cessnock** No: **9132-N**  
 Inspected by: **A. Graham** Date: **18.2.76**  
 Authority: **I.S.D. Newcastle** Field Book: **334**

Beacon Diagram Not to Scale

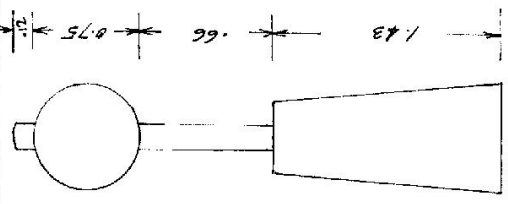

Note: Cross out word or words which do not apply

This Trig. Station has been:

1. Completely cleared to permit 360° vision to surrounding Trigs. ✓
2. Cleared by lances bearing ..... from Trig. Mast
3. Trig. Mast & Vanes have been painted white & black respectively. ✓
4. The Trig. was unpiled/not unpiled, dimensions now being:
  - Description of mark: **CONCRETE PILLAR** should be explicit, e.g. Steel plug, Brass plug, Bolt, Concrete Pillar
  - Height of mark: ..... m above rock concrete **1.43** m above G.L.
  - Height of Top Vanes to Top Mark/Top pillar plate: **1.41** m Diameter of Vanes (vertical) **0.75** m.
  - Height of Cairn: **1.43** m. Diameter of Cairn: ..... m.
  - Length of Mast: **1.53** m. (approximate if not unpiled)
5. A **Trig. plug** set in conc./rock has been placed/fd. **1.225** m. bearing **268** °M from Trig. Mast/pillar
6. A **G.I.P.** set in conc./soil has been placed/fd. **4.272** m. bearing **7** °M from Trig. Mast/pillar
7. A **C.S.** set in conc./soil has been placed/fd. **3.932** m. bearing **209** °M from Trig. Mast/pillar
8. A ..... set in conc./rock has been placed/fd. .... m. bearing ..... °M from Trig. Mast/pillar
9. Connection **Trig. plug to G.I.P.** **5.618** m. bearing **21** °M
10. Connection **Trig. plug to C.S.** **3.448** m. bearing **188** °M
11. Connection to ..... m. bearing ..... °M
12. Connection to ..... m. bearing ..... °M
13. Diff. Ht. **Pillar plate** is **1.557** m. above **Trig. Plug**
14. Diff. Ht. **Pillar plate** is **1.486** m. above **G.I.P.**
15. Diff. Ht. **Pillar plate** is **1.777** m. above **C.S.**
16. Diff. Ht. **Trig. plug** is **0.213** m. above **C.S.**

Trig. plug is 0.77m below G.I.P.

Date	Record of Station
Feb 76	Pillar erected

Prepared by:


Checked: **A. Burrows**

STATION **MARWOOD** (P)<sub>TS</sub> **5548**

Owners Name: ..... Current Occupant: .....

Address: ..... Address: .....

Access: ..... Kms. Feature

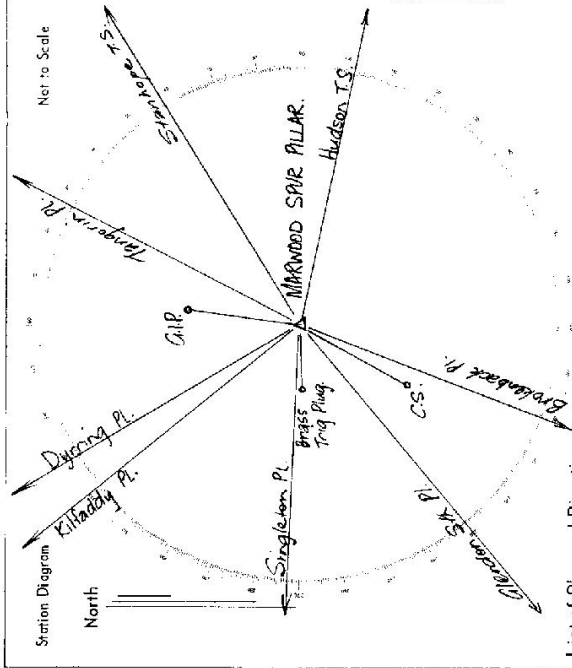

List of Observed Directions:

Station	Direction	Station	Direction
Oliveron Spk Pl.	0° 00' 00"	Oliveron Spk Pl.	0° 00' 00"
Marwood Spair T.S. (Plug)	38° 52' 07.5"	G.I.P.	151° 46' 48.7"
Singelton Pl.	40° 25' 57.58"	Temperin Pl.	157° 29' 38.8"
Dyering Pl.	90° 11' 52.5"	Marwood Spair Pl.	218° 34' 30.5"
G.I.P.	137° 36' 19"	C.S.	338° 25' 14.0"
Temperin Pl.	157° 26' 20.08"		
Stranmore T.S.	199° 48' 24.17"		
Hudson T.S.	232° 51' 17.67"		
Brokenback Pl.	330° 42' 37.08"		
C.S.	338° 45' 59"		

GEODETTIC SURVEY OF N.S.W.

CENTRAL MAPPING AUTHORITY

GEODETTIC STATION RECONNAISSANCE and MAINTENANCE REPORT

Description:

1. Cleared by lanes bearing... *Note: Cross out word or words which do not apply*  
 This station is... *1.520 m. (approximate if not supplied)* from Trig. Mast  
 Mast & Vanes have been painted white & black respectively. *(Very small sockets, brushbook only)*  
 Inspected. *Massive Vanes were rebranded*  
 The station/pillar was *rebranded on 11 April 1973*  
 Description of mark: *Steel cap screws placed in 1/2" x 1/2" plate*  
 Description of mark: *Steel cap screws placed in 1/2" x 1/2" plate*  
 Height of mark: *1.420 m. above G.L.*  
 Height of Top Vanes to Top of Plate: *1.410 m.* Diameter of Vanes (vertical): *1.750 m.*  
 Height of Cairn: *1.520 m.* Diameter of Cairn: *1.750 m.*  
 Length of Mast: *1.520 m.* (approximate if not supplied) *C.M.A. Geodetic Station*  
 4. A. *Copper Nail* set in conc./rock has been placed/found, bearing *208.0° M* from *Mast/Plug/Pillar*  
 5. A. *Copper Nail* set in conc./rock has been placed/found, bearing *7.0° M* from *Mast/Plug/Pillar*  
 6. A. *Copper Nail* set in conc./rock has been placed/found, bearing *7.0° M* from *Mast/Plug/Pillar*  
 7. A. *Copper Nail* set in conc./rock has been placed/found, bearing *7.0° M* from *Mast/Plug/Pillar*  
 8. Action required: *None*

STANDPOINT:

Mark	Direction	Horiz. Distance	Height Difference	Mark	Direction	Horiz. Distance	Height Difference
			above standpt				above standpt
			below				below
			above standpt				above standpt
			below				below
Prepared by: *T. N. C.*

Checked: *T. N. C.*

Noted on U.T.M. Card

SI 2735-1

STATION: **MARWOOD (Pillar)** No.: **5548**

MAP SHEET SCALE 1:250 000

INSPECTED BY: **D.J. Kain** DATE: **11 April 1973**

AUTHORITY: **C.M.A.** FIELD BOOK: **1673**

<p>61-2733-2 D. West, Government Printer</p> <p>Beacon Diagram</p>	<p>STATION <u>MARINCOIL STATION (RING) TS 5548</u></p> <p>Owner's Name: .....          Address: .....          Phone: .....</p> <p>Current Occupant: .....          Address: .....          Phone: .....</p> <p>Access Report of...../1B.....was found suitable/unusable.</p> <p style="text-align: center;"><u>ACCESS</u></p>	<p>Date</p> <p>Record of Station</p>
<p>This section to be completed by officer constructing pillar.</p> <p>Original station mark found/not found. ....</p> <p>Description of mark: .....</p> <p>Original beacon found/not found. ....</p> <p>Description of beacon: .....</p> <p>Height Top of Vane to Top Mark.....m.              above                      below</p> <p>Height of mark.....m.                      rock/cont.....m.                      G.L.              below                      above</p> <p>Diameter of Vane.....m.                      Height of Cairn.....m.</p> <p>Original Beacon has/has not been destroyed by me.</p>		