





CENTRAL MAPPING AUTHORITY

Trigonometric J. Survey of N.S.W.

Department of Lands

RECONNAISSANCE and MAINTENANCE REPORT

STATION **MUGGA (Pillar) (P.S. 5563)**

Co: **Bourke** Ph: **CLERMONT**

Map Sheet: **WYALONG** No: **8530**


Inspected by: **P. B. B.** Date: **9/12/76**

Authority: **C.M.A.** Field Book: **01400 (7)**

This Trig. Station has been:-

Note: Cross out word or words which do not apply

1. ~~Completely cleared to permit 360° vision to surrounding Trig.~~
  2. Cleared by lanes bearing **60° 4' 15" 188° 6' 19" 209° 6' 28" from Trig. Mast (Pillar)** **29° 4' 33"**
  3. Trig. Mast & Vanes have been painted white & black respectively.
  4. The Trig. was unpiled/~~not unpiled~~, dimensions now being: Original Station Mark found/~~not found~~
- Description of mark: **Concrete pipe, ABSOLUTE PILLAR**, should be explicit, e.g. Steel plug, Brass plug, Bolt, G.I. Pipe
- Height of mark: **1.432** m <sup>above</sup>/<sub>below</sub> **1.530** m <sup>above</sup>/<sub>below</sub> G.L. / Diameter of Vanes (vertical) **0.750** m /
- Height of Top Vanes to Top Mark: ..... m. Diameter of Cairn: ..... m.
- Height of Cairn: ..... m. Diameter of Cairn: ..... m.
- Length of Mast: ..... m. (approximate if not unpiled)
5. **TRIG. PILLAR** set in conc/rock has been placed. **3.084** m. bearing **330° 0' 0"** from Trig. Mast **PILLAR**.
  6. **G.I. PIPE** set in conc/soil has been placed. **3.153** m. bearing **192° 0' 0"** from Trig. Mast **PILLAR**.
  7. **ALUMINUM** set in conc/soil has been placed. **4.272** m. bearing **22° 0' 0"** from Trig. Mast **PILLAR**.
  8. **A** set in conc/rock has been placed. .... m. bearing .....°M from Trig. Mast

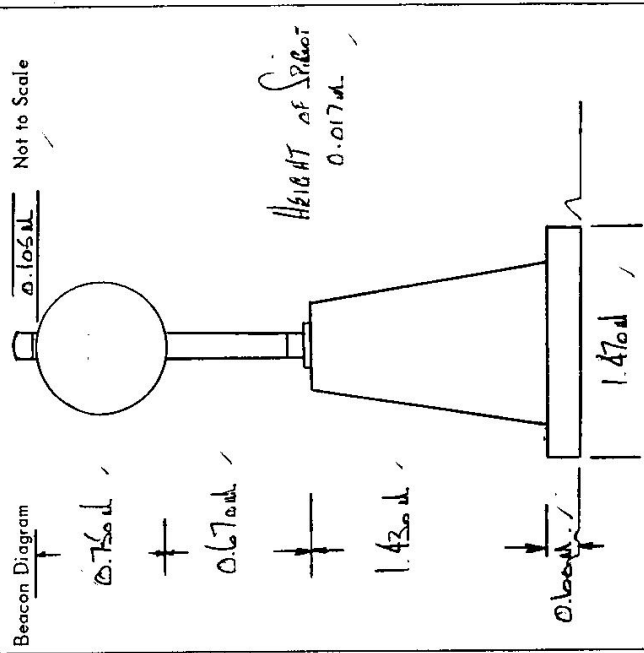

Date	Record of Station
15/3/76	Conc. Obs. pillar constructed.

Prepared by: **R. B. B.** 17/12/76 Checked: **R. D. B.** 21-12-76 Noted on U.T.M. Card

Checked



CENTRAL MAPPING AUTHORITY

GEODETIC STATION RECONNAISSANCE and MAINTENANCE REPORT

- Description: *Note: Cross out word or words which do not apply*
- Cleared by lanes bearing *266° 307° 146° 186°* from Trig. Mast
  - Mast & Vanes have been painted white & black respectively.
  - The station/pillar was *unpainted/not unpainted/constructed*, dimensions now being: *10*
- Description of mark *Pillar Plate* should be explicit, e.g., S/Steel Pillar Plate, Steel plug, Brass plug, Bolt, G.I. Pipe
- Height of mark: *above* rock/concrete, Mark is *1.5* m. *above* G.L.
- Height of Top Vanes to *Top* Mark/Pillar plate *1.42* m. Diameter of Vanes (vertical) *0.74* m.
- Height of *Cap* *0.74* m. Diameter of *Cap* *0.74* m. Name Plate found/*not found*/placed.
- Length of Mast *0.74* m. *approximately if not emptied*
- A. *Stallies not searched for. Likely to be on* set in conc/rock has been placed/ found, bearing *198° 255° 14°* M from Mast/Plug/Pillar
  - A. *Clearing* set in conc/rock has been placed/ found, bearing *198° 255° 14°* M from Mast/Plug/Pillar
  - A. set in conc/rock has been placed/ found, bearing *198° 255° 14°* M from Mast/Plug/Pillar
  - A. set in conc/rock has been placed/ found, bearing *198° 255° 14°* M from Mast/Plug/Pillar
- Action required: *Clearing*

STANDPOINT:			
Mark	Direction	Horiz. Distance	Height Difference
			above standpt.
			below standpt.
			above standpt.
			below standpt.
Prepared by: *I. W. Robins 9/2/81* Checked: *I. W. Robins 9/2/81* Noted on U.T.M. Card

STATION: *MULGA (P)* No.: *3553*

MAPSHEET SCALE 1:250 000 *FOR BES*

INSPECTED BY: *I. W. Robins* DATE: *21/1/81*

AUTHORITY: *C.M.A.* FIELD BOOK: *1903*

Station Diagram

*21987 Clearing* *Residual* *FOR GPS*

ONE PILE *17° Elev 344° M*

ONE PILE *14° Elev 355° M*

*20 mins to Clear 20° Elev 152° 184° M*

*20 mins to Clear 10° Elev 198° 255° M*

*At least ONE DAY to RE-OPEN LANES*

*Pillar found in good order*

*+ Virtually no clearing from 0° M to 140° now possible as that area is Blue Mallee plantation i.e. commercial forest.*

Not to Scale


GS2

STATION MULGA TS 5553

Owner's Name: *Believed to be King's grave.*  
 Address: *TALLIMBALONG*  
 Phone: *NS. "S.P." = Sign posted.*  
 Current Occupant: *G.R. DAVIS ?*  
 Address: *EUKALYPTUS P.O.S. WEST WYALONG*  
 Phone: *TALLIMBALONG*

**NEW ACCESS**

Access Report of *27/3/1978* was found suitable/*unsuitable*.  
 Key  
 00 West Wyalong Post Office; head west on Newell Highway  
 044 Turn left into Narandera turn off - still Newell Highway  
 3-05 Go straight ahead SP Tallimba" passing "Huy to Hernandez on left  
 10-70 Turn right into property access "Tallimbong" at sign.  
 11-27 Pass fork to left, take right fork SP house & works.  
 11-89 At 5 ways SP "Kangaroo Corner" continue straight ahead  
 2 roads on right & 1 road on left.  
 12-40 Pass track to right SP "The Trail", continue on main track  
 12-66 At sign, buildings on left take 90° turn to right i.e. North & follow along edge of Mallee plantation to fence  
 13-06 Follow track around to left at fence line; track follows fence  
 14-27 Through double pipe gates into plantation area. Follow main track  
 14-58 Turn left off main track into minor track  
 14-88 End of plantation area; follow track, pass small track on left  
 15-07 Pass dam on left  
 15-19 Turn left off track at blazed tree on left, follow faint track  
 15-22 Leave track at edge of Mallee plantation. Head 2540 M to pillar at top of Low rise  
 15-43 MULGA G.S.

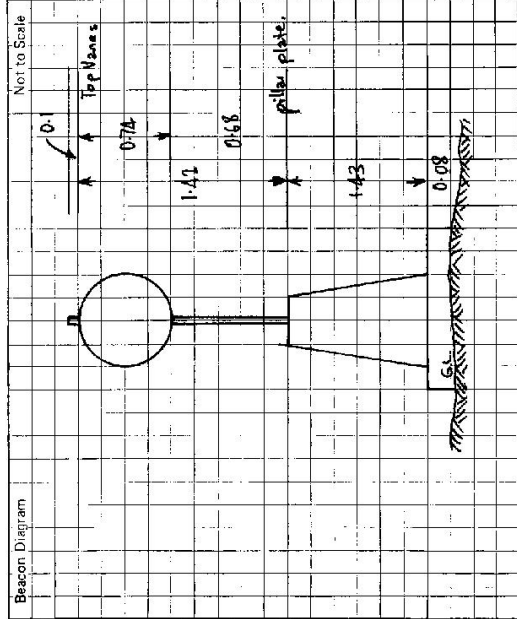

This section to be completed by officer constructing pillar.

Original station mark found/not found.  
 Description of mark: .....  
 Original beacon found/not found.  
 Description of beacon: .....  
 Height Top of Vanes to Top Mark ..... m.  
 Height of mark ..... m. above G.L. below  
 Diameter of Vanes ..... m. Height of Cairn ..... m.  
 Original Beacon has/has not been destroyed by me.

Date	Record of Station
2/9/87	STATION VISITED NEEDS APPROX 1 DAY CLEARING TO OPEN LANES (OWNER NOT AT HOME)