

CENTRAL MAPPING AUTHORITY
Department of Lands

Trigonometrical Survey of N.S.W.

RECONNAISSANCE and MAINTENANCE REPORT

This Trig. Station has been:-

Note: Cross out word or words which do not apply

1. Completely cleared to permit 360° vision to surrounding Trigs.
2. Cleared by limes bearing 58.75, 22.238, 247.275, 109.9 from Trig. Mast
3. Trig. Mast & Vanes have been painted white & black respectively.
4. The Trig. was unpiled/~~not unpiled~~, dimensions now being:

Description of mark..... Plug, i.e., stone should be explicit, e.g. Steel plug, Brass plug, Bolt, G.I. Pipe

Height of mark..... m above below rock/concrete m above below G.L.

Height of Top Vanes to Top Mark..... 3.50 .. m. Diameter of Vanes (vertical)..... 0.91 .. m.

Height of Cairn..... 1.40 .. m. Diameter of Cairn..... 2.50 .. m.

Length of Mast..... 2.60 .. m. (approximate if not unpiled)

5. A..... set in conc/rock has been placed..... m. bearing..... °M from Trig. Mast
6. A..... set in conc/sail has been placed..... m. bearing..... °M from Trig. Mast
7. A..... set in conc/soil has been placed..... m. bearing..... °M from Trig. Mast
8. A..... set in conc/rock has been placed..... m. bearing..... °M from Trig. Mast

9. Connection..... to..... m. bearing..... °M

10. Connection..... to..... m. bearing..... °M

11. Connection..... to..... m. bearing..... °M

12. Connection..... to..... m. bearing..... °M

13. Diff. Ht. is..... m. above below

14. Diff. Ht. is..... m. above below

15. Diff. Ht. is..... m. above below

16. Diff. Ht. is..... m. above below

Prepared by: B J MITCHELL 5-8-75 Checked: J H GILLIES 6-11-75 Noted on U.T.M. Card

STATION MUNDONEN TS 5556


Co: KING Ph: MANTON

Map Sheet: GUNNING No: 8728

Inspected by: J.H.GILLIES Date: 2-7-75

Authority: D.M.R. Field Book:

Beecon Diagram Not to Scale

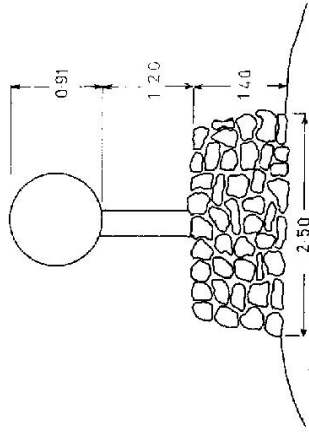


Date

Record of Station

Checked

STATION MUNDOONEN TS 5556

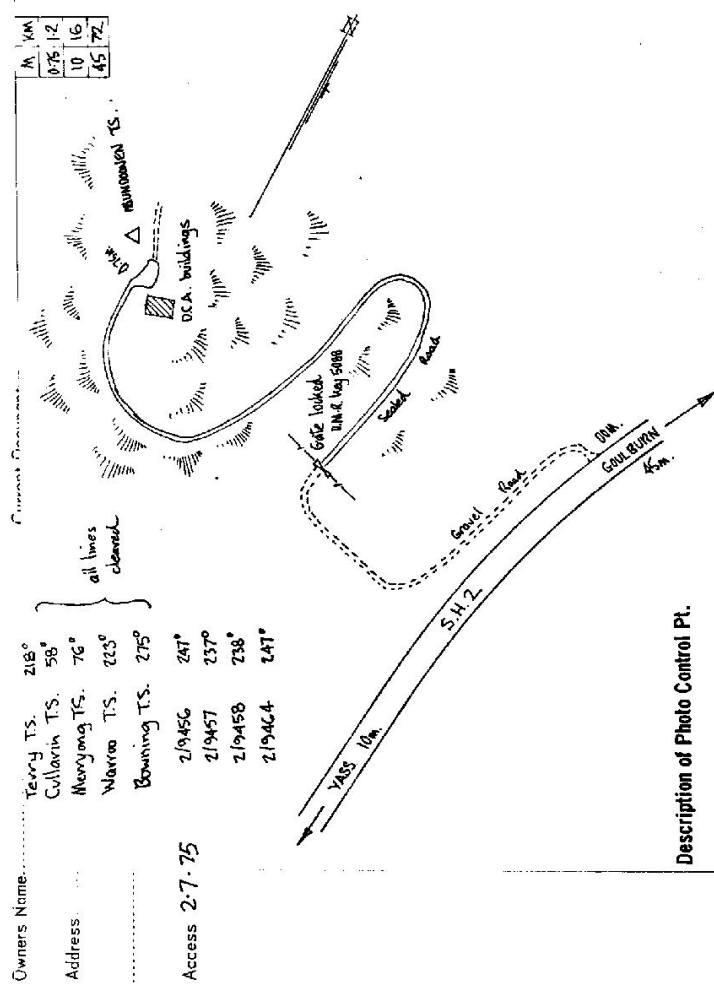

M	KM
0.75	12
10	16
45	72


all lines cleared

Owners Name: Terry TS. 218°
Collavin TS. 58°
Meryong TS. 76°
Worra TS. 223°
Bowring TS. 275°

Address:

Access 2-7-75

2/9456 247°
2/9457 257°
2/9458 238°
2/9464 247°

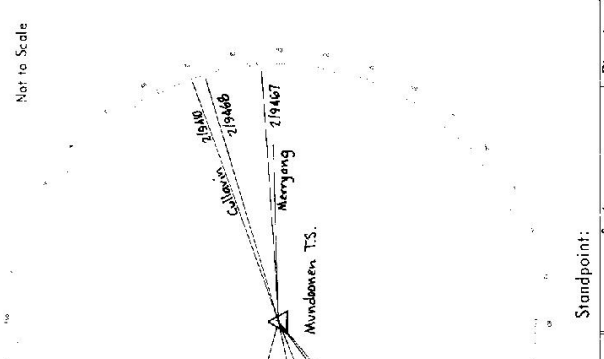

List of Observed Directions:-

Station	Direction	Station	Direction

Description of Photo Control Pt.

SURVEYOR *J.A. Lill*
Date 3/2/75

Photo Target required : YES/NO
P1443

CENTRAL MAPPING AUTHORITY
Department of Lands

Trigonometrical Survey of N.S.W.

RECONNAISSANCE and MAINTENANCE REPORT

This Trig. Station has been:-

Note: Cross out word or words which do not apply

1. Completely cleared to permit 360° vision to surrounding Trigs. ✓
2. Cleared by ~~James bearing~~ from Trig-Mast
3. Trig. Mast & Vanes have been painted white & black respectively. ✓
Pls. constructed 24/176
4. The Trig. was unpiled/~~not unpiled~~, dimensions now being: _____
Description of mark: Steel Plate should be explicit, e.g. Steel plug, Brass plug, Bolt, G.I. Pipe

Height of mark: _____ m above rock/concrete 1.315 m above ~~below~~ G.L.

Height of Top Vanes to Top Mark: 1.440 m. Diameter of Vanes (vertical): 0.755 m.

Height of Cairn: _____ m. Diameter of Cairn: _____ m.

Length of Mast: _____ m. (approximate if not unpiled)

5. Trig. Plug set in conc/rock has been ~~placed~~ ^{found} 0.575 m. bearing 190° from Trig. ~~Mast~~ Pls
6. A. set in conc/soil has been placed _____ m. bearing _____°M from Trig. Mast
7. A. set in conc/soil has been placed _____ m. bearing _____°M from Trig. Mast
8. A. set in conc/rock has been placed _____ m. bearing _____°M from Trig. Mast

9. Connection _____ to _____ m. bearing _____°M

10. Connection _____ to _____ m. bearing _____°M

11. Connection _____ to _____ m. bearing _____°M

12. Connection _____ to _____ m. bearing _____°M

13. Diff. Ht. Trig. Plug in conc Pl is 0.911 m. below Plate

14. Diff. Ht. _____ is _____ m. above below


15. Diff. Ht. _____ is _____ m. above below

16. Diff. Ht. _____ is _____ m. above below

Prepared by: Talbot 15/10/76 Checked: D. Smith Noted on U.T.M. Card

45 5556
STATION MUNDOONEN G.S (Pillar)
Co: KING Ph: MANION
Map Sheet: GUNNING SOUTH No: E72E
Inspected by: A.C BORDER Date: 3/6/76
Authority: C.M.A Field Book: 1404

Beacon Diagram Not to Scale

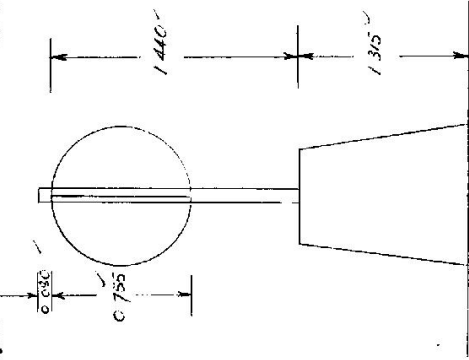

Date: 31/1/76 Record of Station

Original Beacon remained and replaced by
new old pillar.


Checked

STATION *MUNDODOMEN G S (Pillar)* TS *5556*

Owners Name: Current Occupant:

Address: Address:

Access

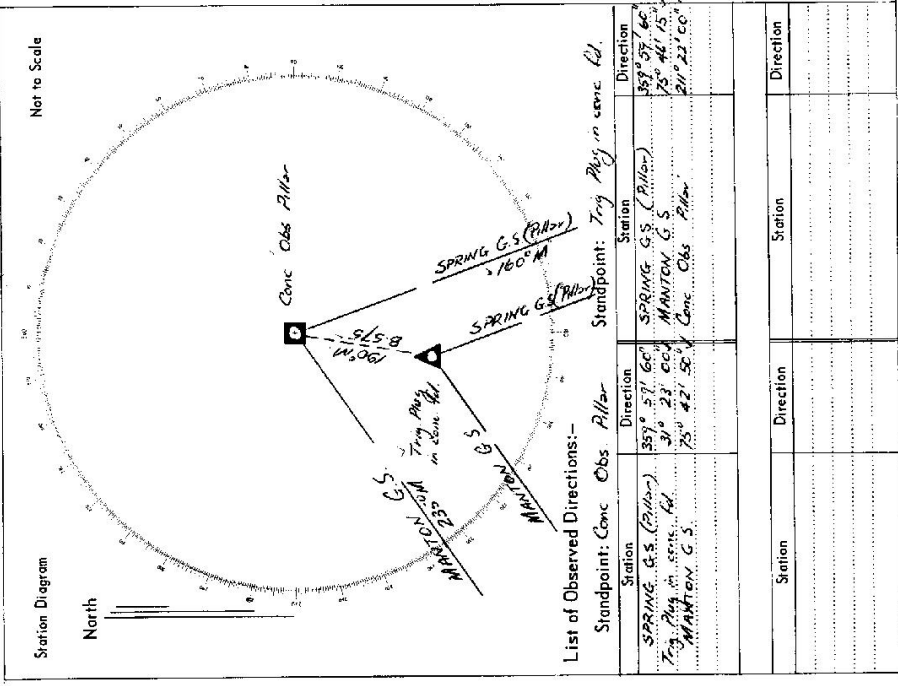

Station	Direction	Station	Direction

GEODETIC SURVEY OF M.S.W.

CENTRAL MAPPING AUTHORITY


GEODETIC STATION RECONNAISSANCE and MAINTENANCE REPORT

STATION: **MUNDOONEN (P)** No.: **5556**

MAP SHEET SCALE 1:250 000 **GOULBURN**

INSPECTED BY: **H.C.BORDER** DATE: **6-6-80**

AUTHORITY: **C.M.A** FIELD BOOK:

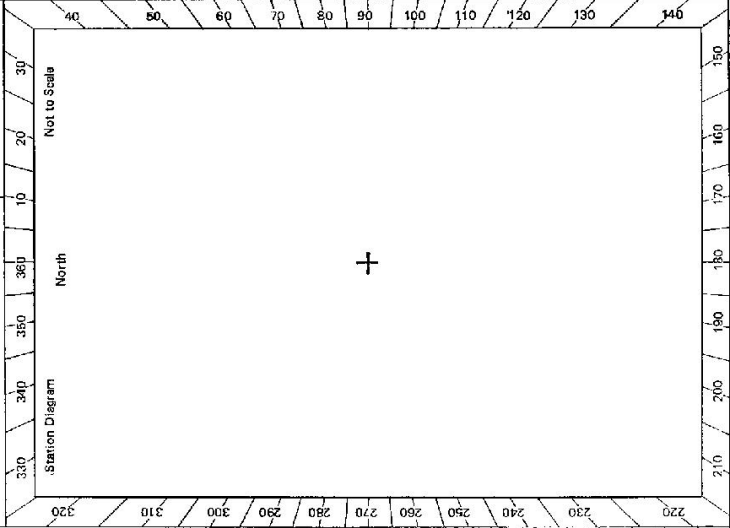

Description:

1. Cleared by lances bearing..... Note: Cross out word or words which do not apply

2. Mast & Vanes have been painted white & black respectively.

3. The station/pillar was unpiled/~~not completed~~/completed on..... **6.6.80**....., dimensions now being:

Description of mark..... **Steel Plate** should be explicit, e.g., S/Steel Pillar Plate, Steel plug, Brass plug, Bolt, G.I. Pipe

Height of mark.....m. ^{above} rock/concrete; Mark is.....m. ^{above} G.L.

Height of Top Vanes to Top ~~Mark~~/Pillar plate **1.435**.....m. Diameter of Vanes (vertical) **0.755**.....m.

Height of Cairn.....m. Diameter of Cairn.....m. Name Plate found/~~not found~~.....

Length of Mast.....m. (approximate if not unpiled)

4. A.....set in conc./rock has been placed/found, bearing.....° M from Mast/Plug/Pillar

5. A.....set in conc./rock has been placed/found, bearing.....° M from Mast/Plug/Pillar

6. A.....set in conc./rock has been placed/found, bearing.....° M from Mast/Plug/Pillar

7. A.....set in conc./rock has been placed/found, bearing.....° M from Mast/Plug/Pillar

8. Action required:.....

STANDPOINT:

Mark	Direction	Horiz. Distance	Height Difference	Mark	Direction	Horiz. Distance	Height Difference
			above standpt.				above standpt.
			below				below
			above standpt.				above standpt.
			below				below
Prepared by:


Checked:

S: 2733-1

Checked

Noted on U.T.M. Card

GS

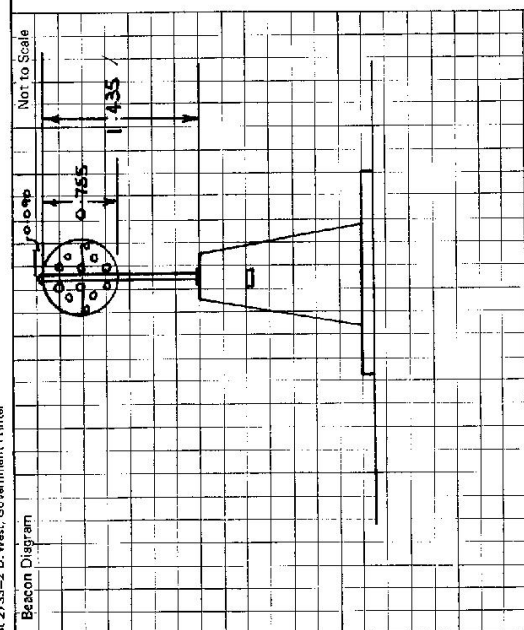STATION MUNDOONEN (P) IS 5556	Owner's Name: Address: Phone: Current Occupant: Address: Phone: Access Report of...../19.....was found suitable/unsuitable. ACCESS
Beacon Diagram 	This section to be completed by officer constructing pillar. Original station mark found/not found. Description of mark: Original beacon found/not found. Description of beacon: Height Top of Vanes to Top Markm. Height of markm. above below G.L. Diameter of Vanesm. Height of Cairnm. Original Beacon has/has not been destroyed by me.
Date 6-6-80	Record of Station New mast & vane straps placed (Original mast burnt in bush fire)

St. 2733-2 D. West, Government Printer

CENTRAL MAPPING AUTHORITY

GEODETIC SURVEY OF N.S.W.

GEODETIC STATION RECONNAISSANCE and MAINTENANCE REPORT

Description:

1. Cleared by lances bearing 360° ✓ *Note: Cross out word or words which do not apply* from Trig. Mast
2. Mast & Vanes have been painted white & black respectively.
3. The steel/pillar was **VISITED** on **27th Nov 84**, dimensions now being:
Description of mark: **S/Steel Pillar Plate, Steel plug, Brass plug, Bolt, G.I. Pipe**
Height of mark: **1.315** m. above **rock/concrete**; Mark is **1.315** m. above **G.L.**
Height of Top Vanes to Top Mark/Pillar plate **1.435** m. Diameter of Vanes (vertical) **0.755** m.
Height of Cairn: m. Diameter of Cairn: m. Name Plate found/~~not found~~ **placed**.
- Length of Mast: m. (approximate if not unplied)
4. A **1.315** m. set in conc/rock has been **placed**/found, bearing **190**° M from **Mast/Plug/Pillar**
5. A set in conc/rock has been placed/found, bearing M from Mast/Plug/Pillar
6. A set in conc/rock has been placed/found, bearing M from Mast/Plug/Pillar
7. A set in conc/rock has been placed/found, bearing M from Mast/Plug/Pillar
8. Action required:

STANDPOINT:

Mark	Direction	Horiz. Distance	Height Difference	Mark	Direction	Horiz. Distance	Height Difference
			above standpt.				above standpt.
			below				below
			above standpt.				above standpt.
			below				below
Prepared by: **LCM**

Checked: **BS**

Noted on U.I.M. Card **10**

SI 2733-1

STATION: **MUNDONNEN CS (P)** No.: **5556**
 MAP SHEET SCALE 1:250 000 **GOULBURN**
 INSPECTED BY: **L. WILKINS** DATE: **27 11 84**
 AUTHORITY: **CMA** FIELD BOOK: **C281**

Station Diagram

North

Not to Scale

Checked **BS** 7/8/85

