

7.4.93

Trigonometrical Survey of N.S.W.

CENTRAL MAPPING AUTHORITY

Department of Lands

RECONNAISSANCE MAINTENANCE REPORT 4016

STATION SAMZROK

(P)

5561

This Trig. Station has been:

Note: Cross out word or words which do not apply

1. ~~Completely cleared to permit 360° vision to surrounding Trigs.~~
2. ~~Cleared by lens-bearing~~ Top of Cairn ~~Necessary~~ from Trig. Mast
3. Trig. Mast & Vanes have been painted white & black respectively.
4. The Trig. was ~~erected~~ not unpiled, dimensions now being:

Description of mark..... should be explicit, e.g. Steel plug, Brass plug, Bolt, G.I. Pipe

Height of mark..... m ^{above} rock/concrete m ^{below} G.L.

Height of Top Vanes to Top Mark..... m. Diameter of Vanes (vertical)..... m.

Height of Cairn..... m. Diameter of Cairn..... m.

Length of Mast..... m. (approximate) if not unpiled)

5. A..... set in conc/rock has been placed..... m. bearing.....°M from Trig. Mast
6. A..... set in conc/soil has been placed..... m. bearing.....°M from Trig. Mast
7. A..... set in conc/soil has been placed..... m. bearing.....°M from Trig. Mast
8. A..... set in conc/rock has been placed..... m. bearing.....°M from Trig. Mast

9. Connection..... to..... m. bearing.....°M

10. Connection..... to..... m. bearing.....°M

11. Connection..... to..... m. bearing.....°M

12. Connection..... to..... m. bearing.....°M

13. Diff. Ht. is..... m. ^{above} _{below}

14. Diff. Ht. is..... m. ^{above} _{below}

15. Diff. Ht. is..... m. ^{above} _{below}

16. Diff. Ht. is..... m. ^{above} _{below}

Prepared by: P. R. Heldon

Checked:

Noted on U.T.M. Card

Checked

Co: Macquarie

Map Sheet: Port Macquarie 1:500 Series No: 923-11-S

Inspected by: Peley R. Heldon

Date: 13.4.75

Field Book:

Beacon Diagram


Not to Scale

Date

Record of Station

STATION **SANCROX T.S.O.P. 5561**

Owners Name.....
 Current Occupant.....
 Address.....
 Address.....
 Access.....

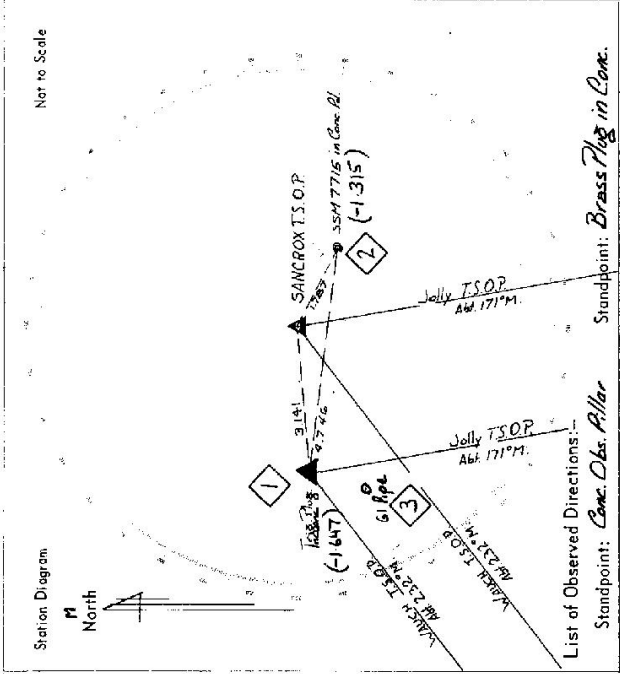

List of Observed Directions:

Standpoint: **Conc. Obs. Pillar** Station: **Brass Plug in Conc.**

Station	Direction	Station	Direction
WACH T.S.O.P.	353° 58' 60"	WACH T.S.O.P.	353° 58' 60"
BRASS PILLAR IN CONC. PL.	33° 01'	Obs. Pillar Spigot	243° 05'
SANCROX T.S.O.P.	243° 05' 26"	SSM (7715) IN CONC. PL.	334° 43'
JOLLY T.S.O.P.	337° 05' 04"	JOLLY T.S.O.P.	337° 05' 50"

Station	Direction	Station	Direction

17-22

Integr. Survey of N.S.W.

RECONNAISSANCE and MAINTENANCE REPORT 4010

Department of Lands

This Trig. Station has been:-

Note: Cross out words or words which do not apply

1. ~~Completely cleared to permit 360° vision to surrounding trig.~~
2. Cleared by lanes bearing $64^{\circ} 10' 22''$ and $104^{\circ} 10' 22''$ from Trig. Mast
3. Trig. Mast & Vanes have been painted white & black respectively.
4. The Trig. was ~~unpiled~~ not unpiled, dimensions now being:

Description of mark Concrete Pillar should be explicit, e.g. Steel plug, Brass plug, Bolt, Concrete Pillar

Height of mark m above rock/concrete m below G.L.

Height of Top Vanes to Top Mark/Top pillar plate m Diameter of Vanes (vertical) m.

Height of Cairn m. Diameter of Cairn m.

Length of Mast m. (approximate if not unpiled)

5. A set in conc./rock has been placed/fd m, bearing °M from Trig. Mast/pillar
6. A set in conc./soil has been placed/fd m, bearing °M from Trig. Mast/pillar
7. A set in conc./soil has been placed/fd m, bearing °M from Trig. Mast/pillar
8. A set in conc./rock has been placed/fd m, bearing °M from Trig. Mast/pillar

9. Connection to m, bearing °M

10. Connection to m, bearing °M

11. Connection to m, bearing °M

12. Connection to m, bearing °M

13. Diff. Ht. is m, above below

14. Diff. Ht. is m, above below

15. Diff. Ht. is m, above below

16. Diff. Ht. is m, above below

Prepared by: B. MITCHELL

Checked:

STATION SANGROX (P) 15 5561

Co: MACQUARIE Ph: MACQUARIE

Map Sheet: PORTRMACQUARIE 1:25000 No:

Inspected by: BRIAN MITCHELL Date: 13-1-79

Authority: D.M.R. Field Book:

Beacon Diagram Not to Scale

Mast & Vanes in good order

Date	Record of Station
13-1-79	Station unlevel

