

74-88

Trigonometrical Survey of N.S.W.

CENTRAL MAPPING AUTHORITY

Department of Lands

RECONNAISSANCE and MAINTENANCE REPORT

STATION **Whatts (Pillar) Ts. 5572**

Co: **Northumberland** Ph: **Warrakumbine**
 Map Sheet: **Cross Creek (N)** No: **9132**
 Inspected by: **David J. Kain** Date: **20 Feb 2022**
 Authority: **C.M.A.** Field Book: **014cc**

This Trig. Station has been:-
 Note: Cross out word or words which do not apply

1. Completely cleared to permit 360° vision to surrounding Trigs. ✓
2. Cleared by lanes bearing..... from Trig. Mast
3. Trig. Mast & Vanes have been painted white & black respectively. ✓
 Pillar constructed 19/2/76.
4. The Trig. was unpiled/not-unpiled, dimensions now being:

Description of mark **S/S Pillar. Plate**..... should be explicit, e.g. Steel plug, Brass plug, Bolt, G.I. Pipe
 Height of mark..... **1.5** m above rock/concrete **AT**..... m **G.L.**
 Height of Top Vanes to Top Mark **1.380** m. Diameter of Vanes (vertical) **0.750** m.
 Height of Cairn..... m. Diameter of Cairn..... m.


Length of Mast..... m. (approximate if not unpiled)
 5. **A. Conc. Tole** set in conc/rock has been placed **2.323** m. bearing **259** °M from Trig. Mast
 6. **A. S.S. Mast** set in conc/seal has been placed **5.115** m. bearing **96** °M from Trig. Mast
 7. **A. G.I. Pipe** set in conc/seal has been placed **3.651** m. bearing **339** °M from Trig. Mast

8. **A.** set in conc/rock has been placed..... m. bearing..... °M from Trig. Mast
 9. Connection **S.S. Mast to Steel Plug**: **3.448** m. bearing **278** °M
 Original station measurements before station was unpled.
 10. Connection **G.I. Pipe to G.I. Plug**: **3.832** m. bearing **13** °M
 11. Connection **S.S. Mast to G.I. Pipe**: **5.414** m. bearing **231** °M

12. Connection..... to..... m. bearing..... °M **3.88m**
 13. Diff. Ht. Trig. Plug is **1.618** m. **above** below Pillar. Plate.
 14. Diff. Ht. S.S.M. is **1.532** m. **above** below Pillar. Plate.
 15. Diff. Ht. G.I. Pipe is **1.776** m. **above** below Pillar. Plate.
 16. Diff. Ht. is..... m. **above** below.....

Prepared by: **D. Kain & A. Sirentzen** Checked:

Paul Duff 19/7/76 Noted on U.T.M. Card

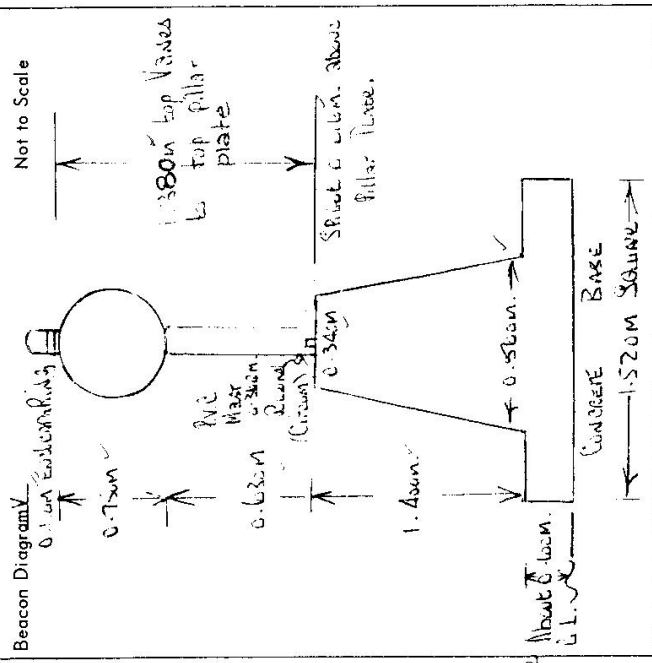


Date	Record of Station
19/7/76	Original Beacon removed and replaced by concrete obs. pillar.

Department of Lands Integration 3 of N.S.W.
RECONNAISSANCE and MAINTENANCE REPORT 4677 STATION **WATTS (P)**
 Co. **NORTHUMBERLAND** Ph: **KIMRIBERTH** TS **5572**

This Trig. Station has been: No: **9132**
 Map Sheet: **CESSNOCK NTH** Date: **8.3.76**
 Inspected by: **PMBEATH** Field Book: **POP 188**
 Authority: **I.S.D. NEWCASTLE**

Beacon Diagram Not to Scale

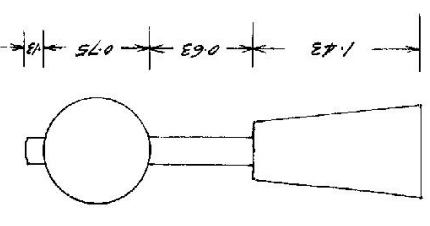

1. Completely cleared to permit 360° vision to surrounding Trigs. ✓
2. Cleared by lances bearing..... from Trig. Mast
3. Trig. Mast & Vanes have been painted white & black respectively. ✓
4. The Trig. was unpiled/not unpiled, dimensions now being:
 Description of mark... **CONCRETE PILLAR** ... should be explicit, e.g. Steel plug, Brass plug, Bolt, Concrete Pillar
 Height of mark... **1.43** m ^{above} ~~below~~ **concrete** ... m ^{above} ~~below~~ **G.L.**
 Height of Top Vanes to Top-Mark/Top pillar plate... **1.38** m Diameter of Vanes (vertical) **0.75** m.
 Height of Cairn... **1.43** m. Diameter of Cairn..... m.
- Length of Mast... **1.51** m. (approximate if not unpiled)
5. A **Brown Trig. Plug** set in conc/~~soil~~ has been placed/rd **2.322** m. bearing... **78**° M from Trig. Mast/pillar
6. A **SSM** set in conc/~~soil~~ has been placed/rd **5.711** m. bearing... **80**° M from Trig. Mast/pillar
7. A **G.I.P.** set in conc/~~soil~~ has been placed/rd **3.651** m. bearing... **147**° M from Trig. Mast/pillar
8. A set in conc/rock has been placed/rd..... m. bearing.....° M from Trig. Mast/pillar
9. Connection **Trig plug to G.I.P.** : **3.837** m. bearing **188**° M
10. Connection **Trig plug to SSM** : **3.445** m. bearing **92**° M
11. Connection to :..... m. bearing.....° M
12. Connection to :..... m. bearing.....° M
13. Diff. Ht. **Pillar Plate** is... **1.617** m. ^{above} ~~below~~ **Old Trig. Plug**.....
14. Diff. Ht. **Pillar Plate** is... **1.529** m. ^{above} ~~below~~ **SSM**.....
15. Diff. Ht. **Pillar Plate** is... **1.772** m. ^{above} ~~below~~ **G.I.P.**.....
16. Diff. Ht. **Trig. plug** is... **1.55** m. ^{above} ~~below~~ **G.I.P.** **Trig plug is 0.082 below SSM**

Date	Record of Station
Feb 76	Pillar erected

Prepared by: **PMBEATH** Checked: **A Burrows**


CENTRAL MAPPING AUTHORITY

STATION: **Watts (Pillar)** No.: **5572**

MAP SHEET SCALE 1:250 000

INSPECTED BY: **D. J. Kinn** DATE: **11 April 1979**

AUTHORITY: **C.M.A.** FIELD BOOK: **1673**

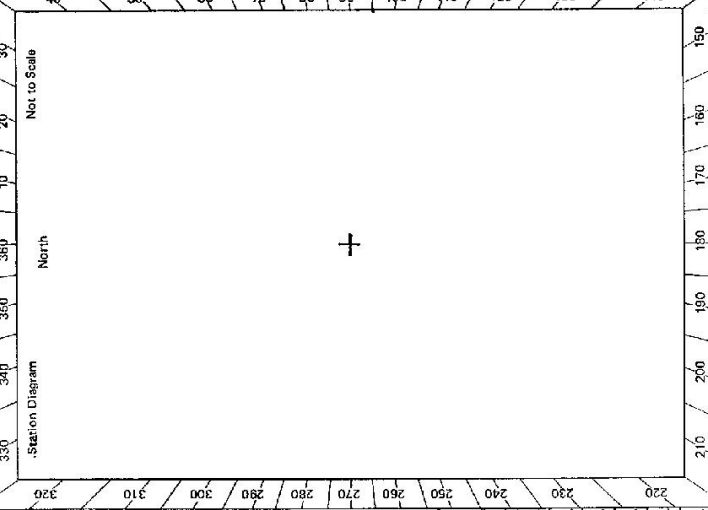

Checked

GEODETTIC STATION RECONNAISSANCE and MAINTENANCE REPORT

- Description:
- Cleared by lanes bearing... *Estimated line for to be cleared from Trig. Mast*
This station. 4 hours. (Small regrowth trees)
 - Mast & Vanes have been painted white & black respectively.
10532800. Mast & Vanes were repainted on 11 April 1979. Dimensions now being:
 - The station/pillar was ~~replaced~~ *replaced* on 11 April 1979. *Head to pillar base.*
 Description of mark: *S/S Pillar. Mark should be explicit, e.g. S/Steel Pillar Plate, Steel plug/Brass plug, Bolt, G.I. Pipe*
 Height of mark: *1.412 m. above rock/concrete; Mark is 1.510 m. above G.L.*
 Height of Top Vanes to Top ~~mark~~ *mark*/Pillar plate *1.370 m.* Diameter of Vanes (vertical) *0.750 m.*
 Height of Cairn: *0.490 m.* Diameter of Cairn: *0.1 m.* Name Plate found/~~not found~~
 Length of Mast: *1.490 m.* (~~approximate if not emptied~~) *L.M.A. Station*
 - A *S.S.M.* set in conc/rock has been ~~placed~~ *found*, bearing *92.7° M* from ~~Mast/Plug/Pillar~~ *Watts*
 - A *G.I. Pipe* set in conc/rock has been ~~placed~~ *found*, bearing *152.0° M* from ~~Mast/Plug/Pillar~~ *Watts*
 - A set in conc/rock has been placed/~~found~~, bearing *0° M* from Mast/Plug/Pillar
 - A set in conc/rock has been placed/~~found~~, bearing *0° M* from Mast/Plug/Pillar

STANDPOINT:			
Mark	Direction	Horiz. Distance	Height Difference
			above standpt.
			below standpt.
			above standpt.
			below standpt.

Prepared by: *D. J. Kinn* Checked: *D. J. Kinn* Noted on U.T.M. Card

STATION Watts (Pillar) TS 5572

Owner's Name:
 Address:
 Phone:

Current Occupant:
 Address:
 Phone:

ACCESS
 Access Report of...../19.....was found suitable/unsuitable.

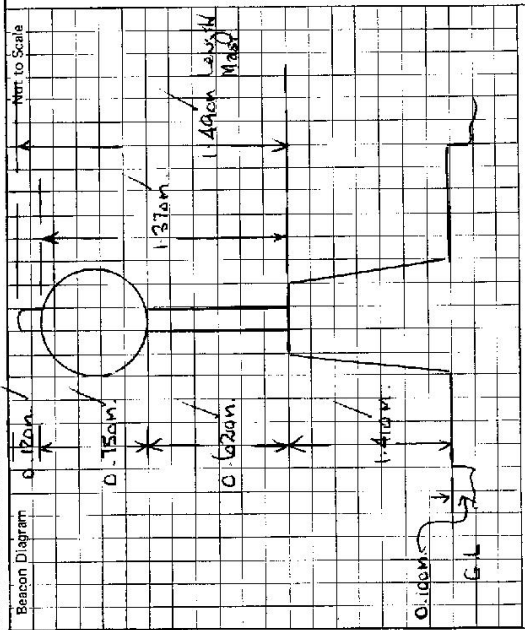

This section to be completed by officer constructing pillar.

Original station mark found/not found.
 Description of mark:
 Original beacon found/not found.
 Description of beacon:
 Height Top of Vanes to Top Mark.....m.
 Height of mark.....m. above G.L. below
 Diameter of Vanes.....m. Height of Cairn.....m.
 Original Beacon has/has not been destroyed by me.

Date	Record of Station

STATION WATTS (P) TS 5572

Owners Name:
 Current Occupant:
 Address:

Address:


Access 8-3-1976

Feature
 Singleton PD Take Pully Rd toward Broke.
 Turn right towards Denman & Lenny's Plains.
 Turn left onto gravel road toward Wainmick.
 Left through makeshift gate and follow well defined road.
 Leave vehicle

21-25
 2 minute walk to Trig

This trig is of easy access by 2 wheel drive vehicle in all weather conditions.

Station Diagram Not to Scale

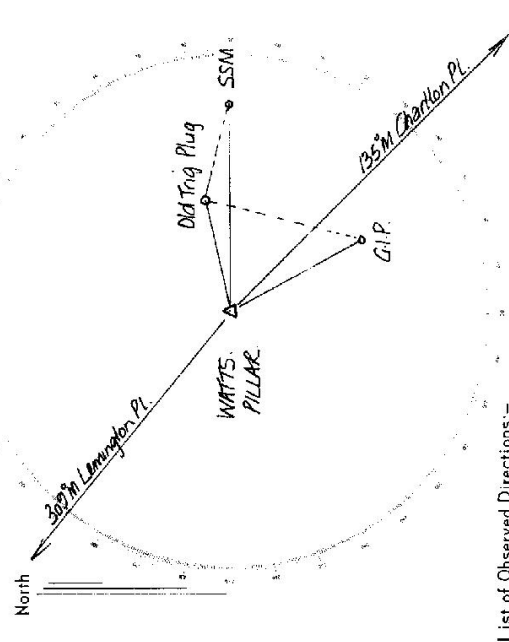

List of Observed Directions:-

Standpoint: WATTS PILLAR		Standpoint: OLD TRIG PLUG	
Station	Direction	Station	Direction
Charlton Pl	0° 00' 00"	Charlton Pl	0° 00' 00"
GIP	17° 47' 36"	G.I.P.	59° 48' 24"
Lennington Pl	170° 13' 55.5"	WATTS Pl.	170° 24' 24"
Old Trig Plug	300° 26' 45.5"	Lennington Pl	170° 11' 51.5"
SSM	311° 21' 05.5"	SSM	348° 00' 05"