

CENTRAL MAPPING AUTHORITY
Department of Lands

Trigonometrical Survey of N.S.W.

RECONNAISSANCE and TRIGONOMETRICAL SURVEY STATION WINGHAM (P)

TABLE 5575

This Trig. Station has been:

Note: Cross out word or words which do not apply

Co: MACCUMBER
Map Sheet: WINGHAM
Inspected by: P. C. MULLOON
Authority:
Beacon Diagram: Not to Scale

1. Completely cleared to permit 360° vision to surrounding Trigs.

2. Cleared by James bearing ~~from Trig-Mast~~

3. Trig-Mast & Vanes have been painted white & black respectively.

4. The Trig. was unpiled/~~not unpiled~~ dimensions ~~new being~~

Description of mark... ~~S/S~~ ~~PIPE~~ ~~IN~~ ~~CONCRETE~~ ~~IN~~ ~~ROCK~~... should be explicit, e.g. Steel plug, Brass plug, Bolt, G.I. Pipe

Height of mark... m above rock/concrete m below G.L.

Height of Top Vanes to Top Mark... m Diameter of Vanes (vertical) ... m

Height of Cairn... m Diameter of Cairn... m

Length of Mast... m (approximate if not unpiled)

5. A... set in concrete has been placed... m, bearing... °M from Trig. Mast

6. A... set in concrete/soil has been placed... m, bearing... °M from Trig. Mast

7. A... set in concrete/soil has been placed... m, bearing... °M from Trig. Mast

8. A... set in concrete has been placed... m, bearing... °M from Trig. Mast

9. Connection to... m bearing... °M

10. Connection to... m bearing... °M

11. Connection to... m bearing... °M

12. Connection to... m bearing... °M

13. Diff. Ht. ... m above below

14. Diff. Ht. ... m above below

15. Diff. Ht. ... m above below

16. Diff. Ht. ... m above below

Prepared by:

Checked:

Noted on U.T.M. Card

Date	Record of Station

STATION WINGHAM P.T.S 5575

Owners Name: H.E. CAREY

Current Occupant:


Address:

Address:

Access 29-7-1977

Direction
 0.0 At Wingham P.O. travelling towards Taree
 1.6 Left turn at Youngs Rd
 2.9 Right turn on gravel track
 4.0 Right into iron gate follow ridge to
 7.1 at trig

North to Scale

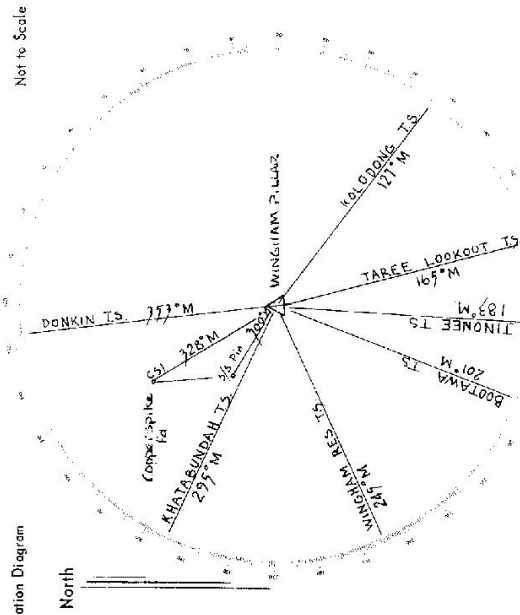

List of Observed Directions:-

Standpoint: Caree Pillar		Standpoint:	
Station	Direction	Station	Direction
TAREE LOOKOUT (Pillar)	164°58' 40" O		
TINONEE (Pillar)	183°51' 45" A		
BOOTAWA (Pillar)	201°52' 54" Z		
WINGHAM RES (Pillar)	240°31' 23" S		
KHATA BENDAH IS.	253°58' 00" I		
Station	Direction	Station	Direction
TARA P.O.	307°11' 50"		
COMPASS PINE IS.	328°14' 10"		
DONKIN IS. (Pillar)	383°45' 11" A		
KELODONG (Pillar)	6°53' 53" Z		