

CENTRAL MAPPING AUTHORITY

Trigonometrical Survey of N.S.W.

Department of Lands

RECONNAISSANCE and MAINTENANCE REPORT

This Trig. Station has been:-

Note: Cross out word or words which do not apply

1. ~~Completely cleared to permit 260m vision to surrounding Triang.~~
2. Cleared by lanes bearing 349.35° N. - 53.71° N. - 86.12° N. - 126.13° - 143.14° from Trig. Mast
3. Trig. Mast & Vanes have been painted white & black respectively. ✓
4. The Trig. was unplied/~~not unplied~~ dimensions now being:
Description of mark ~~BRONZE PLUG~~ PLUG IN ROCK (P) should be explicit, e.g. Steel plug, Brass plug, Bolt, G.I. Pipe
Height of mark..... 6.045 m above ~~rock~~ rock/concrete AT..... m above G.L.
Height of Top Vanes to Top Mark 3.553 m. Diameter of Vanes (vertical) 1.100 m.
Height of Cairn..... 1.170 m. Diameter of Cairn 2.600 m.

Length of Mast 2.500 m. (approximate if not unplied)

5. A. ~~Cone obs. pillar (smaller placed 1ft) to mark 4.147 m. bearing 314.00M from Trig. Mast~~ Plug
~~set in conc/rock has been placed~~

6. A. ~~set in conc/soil has been placed~~..... m. bearing.....°M from Trig. Mast

7. A. ~~set in conc/soil has been placed~~..... m. bearing.....°M from Trig. Mast

8. A. ~~set in conc/rock has been placed~~..... m. bearing.....°M from Trig. Mast

9. Connection..... to..... m. bearing.....°M

10. Connection..... to..... m. bearing.....°M

11. Connection..... to..... m. bearing.....°M

12. Connection..... to..... m. bearing.....°M

13. Diff. Ht. Trig. Plug is 0.700 m. above Pillar Plate

14. Diff. Ht. is..... m. above below

15. Diff. Ht. is..... m. above below

16. Diff. Ht. is..... m. above below

Prepared by:

D. Kani

Checked:

P. B. H.

Noted on U.T.M. Card


19-10-76

Checked

STATION BURRUMUNDI G.S. 5579Co: CUNNINGHAM Ph: YARRABUNDIMap Sheet: BCCAN GATE NTH No: 8431Inspected by: DAVID J. KANI Date: 23rd July 1976Authority: C.M.A. Field Book: 01401

Beacon Diagram

Not to Scale

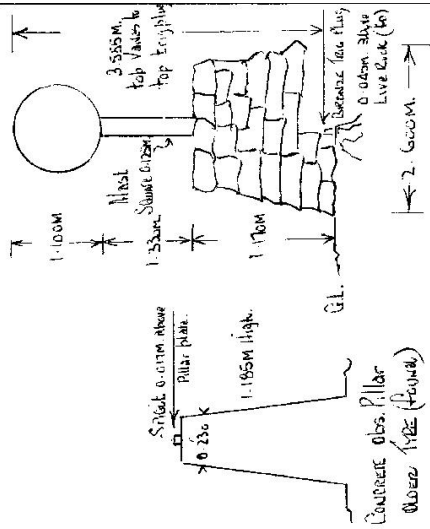

Date

Record of Station

23/7/76 Original text removed and replaced by cone pillar

Current Occupant.....MR. McKinnon.....


Address.....

Owners Name.....MR. MACKY JENNIN

Address.....BURAWANG SOUTH

YARRABANDI.

Access 23-7-1976

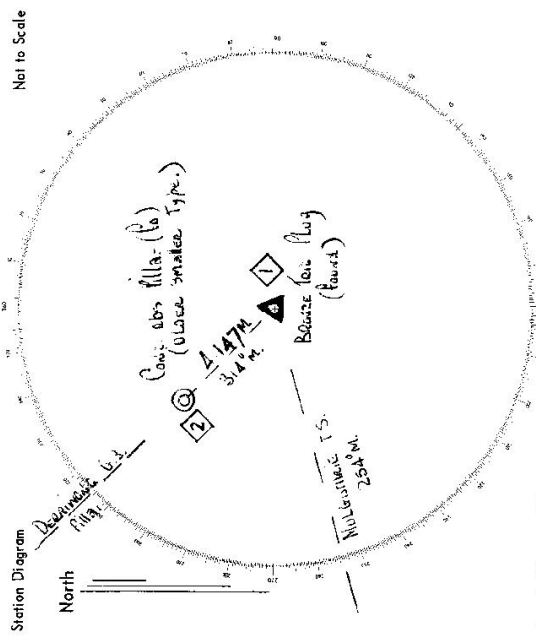

List of Observed Directions:--

Standpoint: Bronze Age Plug		Station	Direction	Station	Direction
Muller (w/24)	1.3	389	59	60	
Decomposed	1.3 (fill)	61	04	20	
{ Cont. obs. fill		61	01	05	
(Chert type (w/24))					

RECONNAISSANCE and MAINTENANCE REPORT

This Trig. Station has been:-

Note: Cross out word or words which do not apply

- | | | | | | |
|----|--|-------|------|---------------------|--|
| 1. | Completely cleared to permit 360° vision to surrounding Trigs. | | | | |
| 2. | Cleared by lanes bearing 340-35° N. - 53-71° N. - 86-120° N. - 124-136° N. - 143-164° N. from Trig. Mast | | | | Pillar. |
| 3. | Trig, Mast & Vanes have been painted white & black respectively. ✓ | | | | |
| 4. | The ^{Pillar} Trig. was unpainted ^{CONSERVED} 23/7/1976, dimensions now being: | | | | |
| | Description of mark | Cont. | obs. | Pillar. | should be explicit, e.g. Steel plug, Brass plug, Bolt, G.I. Pipe |
| | Height of mark | 0.014 | m | above rock/concrete | G.I. |

Diameter of Vanes (vertical) 0.750 m.

Height of Cairn 1.430 m.
Diameter of Cairn — m.

Length of Mastm. (approximate if not unipiled)

- | | | | | | |
|----|---|--------|------------|-----|--------------------|
| 5. | Aboriginal king ^{rudd} plug set in conc ^{placed} rock has been | 4. 142 | m. bearing | 134 | °M from Trig. Mast |
| 6. | A..... set in conc/soil has been placed | | m. bearing | | °M from Trig. Mast |
| 7. | A..... set in conc/soil has been placed | | m. bearing | | °M from Trig. Mast |
| 8. | A..... set in conc/rock has been placed | | m. bearing | | °M from Trig. Mast |

9. Connection.....to.....;.....m. bearing.....°M

0. Connection..... to..... m. bearing.....%M

1. Connection.....to..... m. bearing.....%M

2. Connection.....to.....: m. bearing.....%M

3. Diff. Ht. BRONZE Keig. plug. is 0.970 m. ~~above~~ below Pillar 4 Late.

4. Diff. Ht. is m. above

5. Diff. Ht. s. m. above

6. Diff. Ht. _____ is _____ m. above _____

Prepared by:	D. KAIN	Checked:	PC
--------------	---------	----------	----

Noted on U.T.M. Card


Checked: _____

D Kern

Prepared by:

Checked


10-76

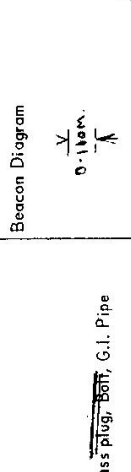

Not to Scale

[illegible]

Not to Scale

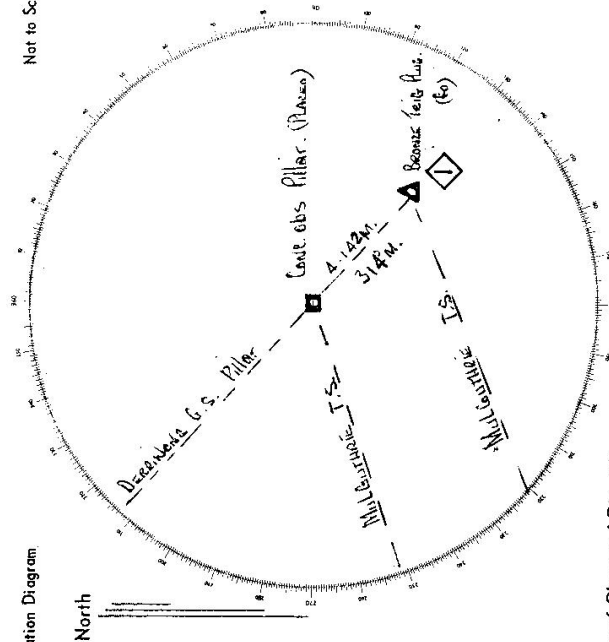

Standpoint: Soc. Abs. Pillar

[illegible]

Owners Name.....Ms. MacKinnon.....
Current Occupant.....Ms. MacKinnon.....

Address.....Bureau of South

Address.....

YARRABANDI.
Node No: YARRABANDI 4.

Access

Access to Burrangong G.S. (Pillar)

AT FORGES POST OFFICE AT 0.0 MILES, TRAVEL NORTH TOWARD BOGAN GATE, PARKES ROAD
KMS
MILEAGE.
FEATURE.

FEATURE.

0.40	TURN LEFT ONTO BOGAN GATE ROAD,
0.25	TAKE SEALED ROAD TO LEFT, SIGN, YARRABANDAT 52 KM.
4.1	PASS KILOMETRE PEG Y6/F52 KM.
32.70	TAKE GRAVEL ROAD TO LEFT, SIGN, 23 KM WARECO BRIDGE.
35.38	PASS ENTRANCE TO BUREANLONG SOUTH ON YOUR RIGHT, OWN
38.80	
55.67	
34.00	

58.95 LAND ON WHICH TRAIL IS SITUATED (MR. MACKINNON.)
58.96 THROUGH BARBED WIRE GATE ON YOUR RIGHT. GATE IS NEAR 2
58.97 Y8 / F60 KM. KILOMETRE LEG

58.57 Y8 / F60 KM.

36. DO TAKE DEEP TRAIL off to YOUR LEFT. SEE sketch.

↑

(10) minutes Easy walk with
Light load.

Not to Scale

KM. PEG Y8/F60

To: Forbes/Bederebung

To YARRABANDI.

Crawford Road.

CENTRAL MAPPING AUTHORITY

GEODETTIC SURVEY OF N.S.W.

GEODETTIC STATION RECONNAISSANCE and MAINTENANCE REPORT

Description:

1. Cleared by lances bearing..... 360° *Note: Cross out word or words which do not apply*
Close Hill at 1829 - 2087 from Trig. Mast

2. Mast & Vanes have been painted white & black respectively. ✓

3. The station/pillar was unpiled/not unpiled/constructed on.....19....., dimensions now being:

Description of mark.....should be explicit, e.g., S/Steel Pillar Plate, Steel plug, Brass plug, Bolt, G.I. Pipe

Height of mark.....m. above rock/concrete; Mark is.....m. above G.L.

Height of Top Vanes to Top Mark/Pillar plate.....m. Diameter of Vanes (vertical).....m.

Height of Cairn.....m. Diameter of Cairn.....m. Name Plate found/not found/placed.

Length of Mast.....m. (approximate if not unpiled)

4. A. *RIGHT. HOLE*.....set in ~~conc~~/rock has been placed/~~found~~, bearing..... 160° M from Mast/Plug/Pillar

5. A.....set in conc/rock has been placed/round, bearing..... $^\circ$ M from Mast/Plug/Pillar

6. A.....set in conc/rock has been placed/round, bearing..... $^\circ$ M from Mast/Plug/Pillar

7. A.....set in conc/rock has been placed/round, bearing..... $^\circ$ M from Mast/Plug/Pillar

8. Action required:.....

STANDPOINT:

STANDPOINT:

Mark	Direction	Horiz. Distance	Height Difference	Mark	Direction	Horiz. Distance	Height Difference
			above standpt.				above standpt.
			below				below
			above standpt.				above standpt.
			below				below
Prepared by:

Checked:

Noted on U.T.M. Card

St 2733-1

STATION: BURRAWONG (P)		No.: 5579	
MAP SHEET SCALE 1:250 000		DATE: 7/9/89	
INSPECTED BY: G. L. FORD		FIELD BOOK: C 537	
AUTHORITY: L. I. C.			

Station Diagram

Not to Scale

North

320 310 300 290 280 270 260 250 240 230 220

330 340 350 360 370 380 390 400

160 170 180 190 200 210

Beacon Diagram <div style="float: right; text-align: right;"> Not to Scale </div>	
<div style="display: flex; justify-content: space-between;"> <div style="width: 45%;"> <p>Owner's Name: <u>JOHN PETERS</u></p> <p>Address: <u>"BURRAWONG SOUTH"</u></p> <p>Phone: <u>068 682 404</u></p> </div> <div style="width: 45%;"> <p>Current Occupant:</p> <p>Address:</p> <p>Phone:</p> </div> </div> <p style="text-align: center; margin-top: 20px;"><u>ACCESS</u></p> <p>Access Report of 21.11.19 was found suitable (unreliable).</p> <p>0.00 FORBES P.D. TRAVEL NORTH TOWARDS BIGGAN GAZE RD.</p> <p>0.40 TURN LEFT ONTO BIGGAN GAZE RD</p> <p>7.56 TAKE SIGNED TO LEFT SIGN "YARRABANDAZ 52 KM"</p> <p>52.61 PASS KILOMETRE PEG 36/152 KM</p> <p>54.38 TAKE ROAD TO LEFT SIGN 23 KM WARROO BRIDGE</p> <p>55.67 PASS ENTRANCE TO "BURRAWONG SOUTH" ON YOUR RIGHT LAND OWNER HOUSE</p> <p>58.25 THROUGH BARBED WIRE GAZE ON YOUR RIGHT GAZE IS NEAR KILOMETRE PEG 48/160 KM</p> <p style="text-align: center; margin-top: 10px;">MAKE WAY THROUGH QUARRY TO BASE OF HILL 10 MINS WALK TO TRIG</p>	
<p style="text-align: center;">This section to be completed by officer constructing pillar.</p> <p>Original station mark found/not found.</p> <p>Description of mark:</p> <p>Original beacon found/not found.</p> <p>Description of beacon:</p> <p>Height Top of Vane to Top Mark:m.</p> <p>Height of mark:m. above G.L. below</p> <p>Diameter of Vane:m. Height of Cairn:m.</p> <p>Original Beacon has/not been destroyed by me.</p>	