

CENTRAL MAPPING AUTHORITY
Department of Lands

Trigonometrical Survey of N.S.W.

RECONNAISSANCE and MAINTENANCE REPORT

This Trig. Station has been:-

Note: Cross out word or words which do not apply

1. Completely cleared to permit ~~260m~~ ^{260m} vision to ~~surrounding~~ ^{trig.}
2. Cleared by lances bearing 15° ~~73m~~ ²⁶² ~~218m~~ from Trig. Mast
3. Trig. Mast & Vanes have been painted white & black respectively. ✓
4. The Trig. was unpiled/~~detached~~, dimensions now being: ~~4.2m~~ ^{4.2m} should be explicit, e.g. Steel plug, Brass plug, Bolt, G.I. Pipe
Description of mark ~~Beacon~~ ^{Steel Plug}
- Height of mark ~~0.043m~~ ^{0.043m} m above ~~mark~~ ^{mark/concrete} ~~concrete~~ ^{G.L.} ~~0.043m~~ m
- Height of Top Vanes to Top Mark ~~3.077~~ ^{3.077} m. Diameter of Vanes (vertical) ~~1.200~~ ^{1.200} m.
- Height of Cairn ~~1.342~~ ^{1.342} m. Diameter of Cairn ~~1.100~~ ^{1.100} m.
- Length of Mast ~~3.070~~ ^{3.070} m. (~~approximate-if-not-verified~~)
Cone, obs. plate (Lunar type) ~~Brass~~ ^{Brass}
5. A. ~~set in conc/rock has been placed~~ ^{set in conc/rock has been placed} ~~2.552~~ ^{2.552} m. bearing ~~27^\circ~~ ^{27^\circ} ~~9M~~ ^{9M} from Trig. ~~mark~~ ^{mark}
6. A. ~~set in conc/soil has been placed~~ ^{set in conc/soil has been placed} ~~0.000~~ ^{0.000} m. bearing ~~0^\circ~~ ^{0^\circ} ~~0M~~ ^{0M} from Trig. Mast
7. A. ~~set in conc/soil has been placed~~ ^{set in conc/soil has been placed} ~~0.000~~ ^{0.000} m. bearing ~~0^\circ~~ ^{0^\circ} ~~0M~~ ^{0M} from Trig. Mast
8. A. ~~set in conc/rock has been placed~~ ^{set in conc/rock has been placed} ~~0.000~~ ^{0.000} m. bearing ~~0^\circ~~ ^{0^\circ} ~~0M~~ ^{0M} from Trig. Mast
Sketch of cone obs. pillar (towards) ~~Block type structure.~~ ^{Block type structure.}
9. Connection ~~to~~ ^{to} ~~0.000~~ ^{0.000} m. bearing ~~0^\circ~~ ^{0^\circ} ~~0M~~ ^{0M}
10. Connection ~~to~~ ^{to} ~~0.000~~ ^{0.000} m. bearing ~~0^\circ~~ ^{0^\circ} ~~0M~~ ^{0M}
Sketch of cone obs. pillar (towards) ~~Block type structure.~~ ^{Block type structure.}
11. Connection ~~to~~ ^{to} ~~0.000~~ ^{0.000} m. bearing ~~0^\circ~~ ^{0^\circ} ~~0M~~ ^{0M}
12. Connection ~~to~~ ^{to} ~~0.000~~ ^{0.000} m. bearing ~~0^\circ~~ ^{0^\circ} ~~0M~~ ^{0M}
13. Diff. Ht. ~~Brass Trig. Plug~~ ^{Brass Trig. Plug} is ~~1.111~~ ^{1.111} m. ~~above~~ ^{below} ~~Pillar~~ ^{Pillar} ~~Rock~~ ^{Rock} (obs. type)
14. Diff. Ht. ~~is~~ ^{is} ~~0.000~~ ^{0.000} m. ~~above~~ ^{below} ~~0.000~~ ^{0.000} m.
15. Diff. Ht. ~~is~~ ^{is} ~~0.000~~ ^{0.000} m. ~~above~~ ^{below} ~~0.000~~ ^{0.000} m.
16. Diff. Ht. ~~is~~ ^{is} ~~0.000~~ ^{0.000} m. ~~above~~ ^{below} ~~0.000~~ ^{0.000} m.

Prepared by:

Checked:

Noted on U.T.M. Card

Checked: *Alan Woodcock*

74-98


STATION CATOMBAL G.S. 5593

Co: CROOKALL Ph: CATOMBAL

Map Sheet: WELLINGTON No: SG32

Inspected by: DAVID J. KAHN Date: 01 September 2021

Authority: C.M.A. Field Book: 01401

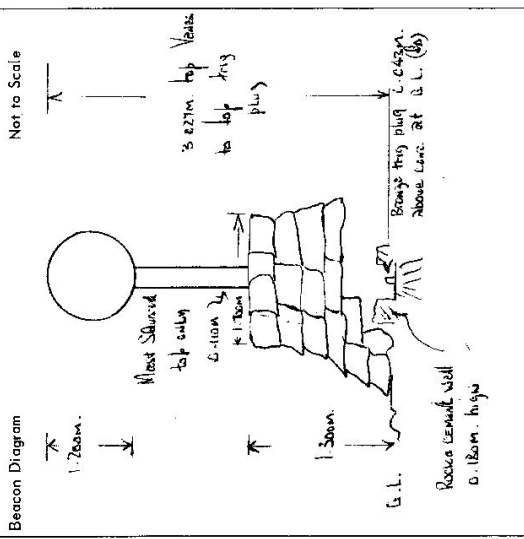

Record of Station

Date	<u>28/11/16</u>
Original Beacon	<u>with replaced and replaced by conc. obs. pillar</u>
Original cone, obs. pillar	<u>found on this station</u>
was considered to	<u>be new obs. pillar and trig plug had been destroyed</u>

CENTRAL MAPPING AUTHORITY
Department of Lands

Trigonometrical Survey of N.S.W.

TS-5593

RECONNAISSANCE and MAINTENANCE REPORT

STATION

CATOMBAL G.S. (Pillar)

This Trig. Station has been:-

Note: Cross out word or words which do not apply

1. Completely cleared to permit ~~360~~ ¹⁸⁰ vision to surrounding ~~trigs.~~
2. Cleared by lances bearing ~~15.13.0~~ ^{15.13.0} ~~262~~ ²⁶² ~~278~~ ²⁷⁸ from Trig. Mast
3. Trig. Mast & Vanes have been painted white & black respectively. ✓
Pillar was constructed on 7/9/1976
4. The Trig. Station was ~~reconstructed~~ ^{reconstructed}, dimensions now being:
Description of mark..... Conc. obs. Pillar should be explicit, e.g. Steel plug, Brass plug, Bolt, G.I. Pipe
Height of ~~mark~~ ^{mark} ~~0.18m~~ ^{0.18m} ~~above mark/concrete~~ ^{above mark/concrete} ~~1.570m~~ ^{1.570m} above G.L.
Height of Top Vanes to Top ~~Mark~~ ^{Mark} ~~1.362~~ ^{1.362} m. Diameter of Vanes (vertical) ~~0.764~~ ^{0.764} m.
Height of ~~Cairn~~ ^{Cairn} ~~1.410~~ ^{1.410} m. Diameter of Cairn..... m.

Length of Mast..... m. (approximate if not uplied)

5. A ~~Brass trig plug~~ ^{Brass trig plug} set in ~~conc/mark~~ ^{conc/mark} has been ~~placed~~ ^{placed} ~~2.246~~ ^{2.246} m. bearing..... ~~334~~ ³³⁴ °M from Trig. ~~Mast~~ ^{Mast} ~~Pillar (obs.)~~ ^{Pillar (obs.)}
6. A ~~Conc. obs. Pillar~~ ^{Conc. obs. Pillar} set in ~~conc/mark~~ ^{conc/mark} has been ~~placed~~ ^{placed} ~~4.334~~ ^{4.334} m. bearing..... ~~10~~ ¹⁰ °M from Trig. ~~Mast~~ ^{Mast} ~~Pillar (obs.)~~ ^{Pillar (obs.)}
7. A ~~Brass trig plug~~ ^{Brass trig plug} set in ~~conc/mark~~ ^{conc/mark} has been ~~placed~~ ^{placed} ~~2.552~~ ^{2.552} m. bearing..... ~~207~~ ²⁰⁷ °M from Trig. ~~Mast~~ ^{Mast} ~~Pillar (obs.)~~ ^{Pillar (obs.)}

8. A..... set in ~~conc/rock~~ ^{conc/rock} has been placed..... m. bearing..... °M from Trig. Mast

9. Connection..... to..... m. bearing..... °M ~~Sketch of Conc. obs. Pillar (class type)~~ ^{Sketch of Conc. obs. Pillar (class type)}

10. Connection..... to..... m. bearing..... °M ~~Sketch of Cairn above 2.00m pillar plate~~ ^{Sketch of Cairn above 2.00m pillar plate}

11. Connection..... to..... m. bearing..... °M

12. Connection..... to..... m. bearing..... °M

13. Diff. Ht. ~~Brass trig plug~~ ^{Brass trig plug} is ~~1.335~~ ^{1.335} m. ~~below~~ ^{below} ~~Pillar Plate (obs.)~~ ^{Pillar Plate (obs.)}

14. Diff. Ht. ~~Conc. obs. Pillar (class type)~~ ^{Conc. obs. Pillar (class type)} is ~~0.221~~ ^{0.221} m. ~~below~~ ^{below} ~~Pillar Plate (obs.)~~ ^{Pillar Plate (obs.)}

15. Diff. Ht. ~~Brass trig plug~~ ^{Brass trig plug} is ~~1.111~~ ^{1.111} m. ~~below~~ ^{below} ~~Pillar Plate (obs.)~~ ^{Pillar Plate (obs.)}


16. Diff. Ht. is m. ~~above~~ ^{above} ~~below~~ ^{below}

Prepared by:

Checked:

Noted on U.T.M. Card

Checked Alan Weerting

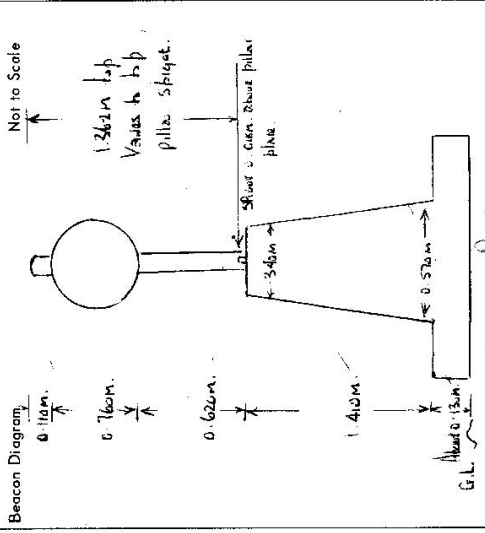

Date	Record of Station
6/9/76	Conc. obs. Pillar (class type) (4) on this station was constructed to take plug (top) into Conc. obs. Pillar (class) and wire into Desiccators.

STATION CATAPUAL G.S. (Pillar) TS - 5593

Owners Name: Mr. LEN MARINOLI. Current Occupant:

Address: St. Mr. Riccardo. Davies Address:

Access: Hill Phone No. Westford 146-B Access To Catapual G.S. (Pillar) 8-9-1976


Access AT FOOT OF THE HILL AT 0.0 MILES, TRAVEL WEST ALONG FENCES SEVERAL ROADS.

- 0-15 CROSS ROAD BEHIND OVER BELL RIVER.
- 0-50 TAKE ROAD TO LEFT SIGNS "18 CREEK CREEK" 108 PARKS 42 YEONAL.
- 6-55 TAKE SEALED ROAD TO LEFT, SIGNPOSTS, 56 CUMOCK, 11 CREEK CREEK.
- 16-20 THROUGH IRON GATE ON YOUR LEFT, SIGNPOST A MAIL BOX, MUREUMBONG.
- 16-40 TAKE RIGHT FENCE IN TRENCH.
- 16-50 THROUGH IRON GATE INTO PROPERTY, MUREUMBONG.
- 16-85 PASS MR. DAVID TAYLOR'S PROPERTY MUREUMBONG HOMETEAD ON YOUR LEFT, FOLLOW KENNEL SOUTH.
- 17-10 THROUGH DOUBLE IRON GATES, FOLLOW TRENCH.
- 17-45 THROUGH DOUBLE IRON GATES, WINDMILL ON YOUR L.H.S., FOLLOW KENNEL.
- 17-70 THROUGH DOUBLE WOODEN GATES, FOLLOW TRENCH.
- 18-40 THROUGH DOUBLE IRON GATES, FOLLOW TRENCH.
- 18-90 THROUGH DOUBLE IRON GATES, FOLLOW TRENCH.
- 19-80 THROUGH DOUBLE IRON GATES, FOLLOW TRENCH NOW EASTERLY.
- 20-35 CREEK CROSSINGS AT 20-05, 20-15, 20-25, 20-30 MILES.
- 20-45 LEAVE MAIN TRENCH, FOLLOW WELL DEFINED TRENCH INTO GRASSY VALLEY IN A NORTHEASTLY DIRECTION.
- 20-80 CROSSING, FOLLOW TRENCH.
- 21-35 AT DOUBLE IRON GATES IN EAST/WEST DIRECTION, FOLLOW TRENCH. IT IS NOT POSSIBLE TO DRIVE ALL THE WAY UP THIS SLOPE ALTHOUGH FENCE DUE TO ROCKS ETC. BUT WITH CAUTION IT IS POSSIBLE NOT TO LEAVE THE FENCE FOR MORE THAN 150 FT OR SO. TILL TOP OF RIDGE IS REACHED.

21-85 TOP OF RIDGE (BLAZED TREES) NOW PASS THROUGH THIS FENCE (NO GATE) PERMISSION TO LEAVE THE RIDGE SHOULD BE SOUGHT. FOLLOW TRAIL ALONG AND UP RIDGE IN A NORTHEASTLY DIRECTION.

22-65 PASS THROUGH EAST/WEST NORTH-SOUTH FENCE (NO GATE).

22-95 CONC. OBS. PILLAR. FENCE (4) WHEN DRIVE VEHICLES ONLY AND IN DRY WEATHER TO THIS STATION.

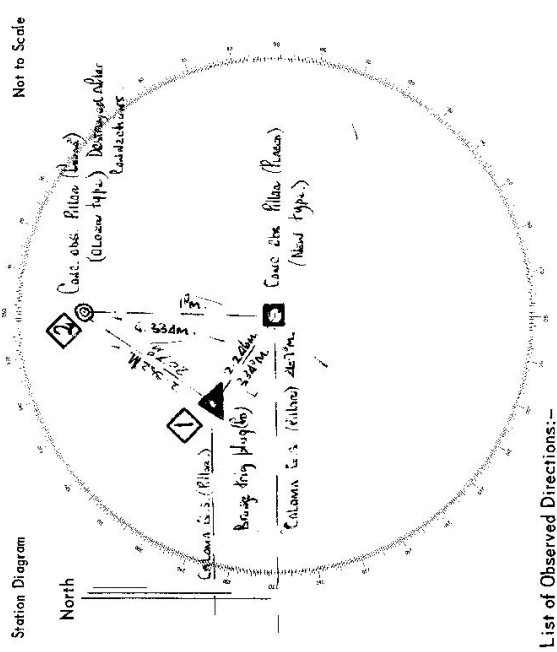

List of Observed Directions:-

Station	Standpoint	Conc. obs. Pillar (New type)	Direction
Catapual G.S. (Pillar)	0.00	0.00	E
Conc. obs. Pillar (New type)	15.49	40	BRIDGE RING PILLAR
Conc. obs. Pillar (New type)	24.58	35	CONC. OBS. PILLAR (PLAIN TYPE)
Conc. obs. Pillar (New type)	24.58	35	CONC. OBS. PILLAR (PLAIN TYPE)
Conc. obs. Pillar (New type)	24.58	35	CONC. OBS. PILLAR (PLAIN TYPE)

Station	Direction	Station	Direction

GEODETTIC SURVEY OF N.S.W.

CENTRAL MAPPING AUTHORITY

GEODETTIC STATION RECONNAISSANCE and MAINTENANCE REPORT

STATION: CATOMBAL G.S. ✓	TS No.: 5593
MAP SHEET SCALE 1:250 000	DUBBO.
INSPECTED BY: A WOODRUFF ✓	DATE: 21 ST AUG 198 ✓
AUTHORITY: CENTRAL MAPPING ✓	FIELD BOOK: 1695 ✓

Station Diagram

Not to Scale

Note: Cross out word or words which do not apply

1. Cleared by lances bearing..... 5^m → 45^m ✓
 from Trig. Mast
2. Mast & Vanes have been painted white & black respectively. ✓
3. The station/pillar was unpiled/not unpiled/constructed on..... 19....., dimensions now being:
 Description of mark..... should be explicit, e.g., S/Steel Pillar Plate, Steel plug, Brass plug, Bolt, G.I. Pipe
 Height of mark.....m. above rock/concrete; Mark is.....m. above G.L.
 Height of Top Vanes to Top Mark/Pillar plate.....m. Diameter of Vanes (vertical).....m.
 Height of Cairn.....m. Diameter of Cairn.....m. Name Plate found/not found/placed.
 Length of Mast.....m. (approximate if not unpiled)
4. A.....set in conc/rock has been placed/found, bearing.....° M from Mast/Plug/Pillar
5. A.....set in conc/rock has been placed/found, bearing.....° M from Mast/Plug/Pillar
6. A.....set in conc/rock has been placed/found, bearing.....° M from Mast/Plug/Pillar
7. A.....set in conc/rock has been placed/found, bearing.....° M from Mast/Plug/Pillar
8. Action required:.....

STANDPOINT:							
Mark	Direction	Horiz. Distance	Height Difference	Mark	Direction	Horiz. Distance	Height Difference
			above standpt.				above standpt.
			below				below
			above standpt.				above standpt.
			below				below
Prepared by: A WOODRUFF Checked: A LAUNDER Noted on U.T.M. Card

CENTRAL MAPPING AUTHORITY GEODETIC SURVEY OF N.S.W.

GEODETIC STATION RECONNAISSANCE and MAINTENANCE REPORT

Description:

1. Cleared by lanes bearing 360° CROSS RANGES BLOCK VISION 95m to 125m, 172m to 175m, 190m to 203m.
Note: Cross out word or words which do not apply
2. Mast & Vanes have been painted white & black respectively.
3. The station/pillar was unpiled/not unpiled/constructed on..... 19....., dimensions now being:

Description of mark.....should be explicit, e.g., S/Steel Pillar Plate, Steel plug, Brass plug, Bolt, G.I. Pipe

Height of mark.....m. ^{above} _{below} rock/concrete; Mark is.....m. ^{above} _{below} G.L.

Height of Top Vanes to Top Mark/Pillar plate.....m. Diameter of Vanes (vertical).....m.

Height of Cairn.....m. Diameter of Cairn.....m. Name Plate found/not found/placed.

Length of Mast.....m. (approximate if not unpiled)

4. A.....set in conc/rock has been placed/found, bearing.....°M from Mast/Plug/Pillar

5. A.....set in conc/rock has been placed/found, bearing.....°M from Mast/Plug/Pillar

6. A.....set in conc/rock has been placed/found, bearing.....°M from Mast/Plug/Pillar

7. A.....set in conc/rock has been placed/found, bearing.....°M from Mast/Plug/Pillar

8. Action required:.....

STANDPOINT:

STANDPOINT:

Mark	Direction	Horiz. Distance	Height Difference	Mark	Direction	Horiz. Distance	Height Difference
			above standpt.				above standpt.
			below standpt.				below standpt.
			above standpt.				above standpt.
			below standpt.				below standpt.
Prepared by: P. Roberts 16.9.85


Checked: P. Roberts

Checked

STATION: CATOMBAL G.S.P. No.: 5593
 MAP SHEET SCALE 1:250 000
 INSPECTED BY: P. Roberts DATE: 12.9.85
 AUTHORITY: C.M.A. FIELD BOOK:

SI 2753-2 D. West, Government Printer

STATION **CATON/DAL G.S(D) TS-5593**

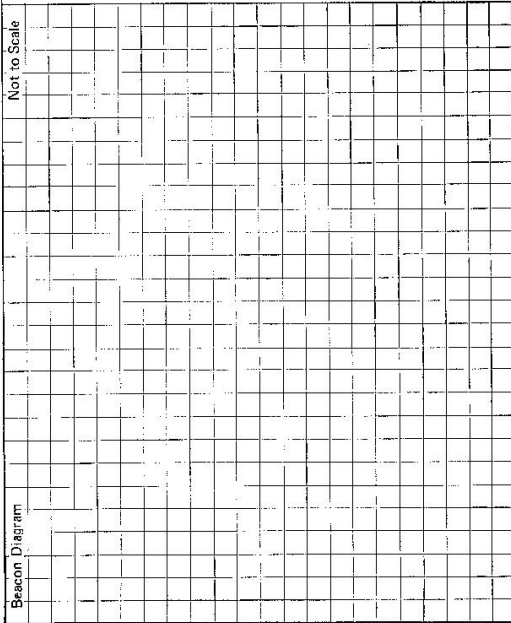

Owner's Name: **JANE RESERVE**
 Address: **3AA19**
 Phone: **06 467 293**
 Access Report of **31.8.19** was found suitable/unsuitable.

Current Occupant: **Access Tower of David Heights**
 Address: **Plaza 1010 10th St**
 Phone:

Addressed by: **MR L A MULL (MANACIA)**
 Phone: **06 467 293**

ACCESS

This section to be completed by officer constructing pillar.

Original station mark found/not found.

Description of mark:

Original beacon found/not found.

Description of beacon:

Height Top of Vanes to Top Markm.

Height of markm. above rock/concm. below G.L.

Diameter of Vanesm. Height of Cairnm.

Original Beacon has/has not been destroyed by me.

Date	Record of Station